


STATE OF KANSAS
STATE CORPORATION COMMISSION

Give All Information Completely
Make Required Affidavit
Mail or Deliver Report to:
Conservation Division
State Corporation Commission
211 No. Broadway
Wichita, Kansas

WELL PLUGGING RECORD

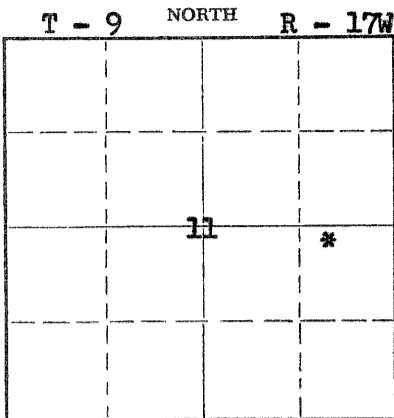

Locate well correctly on above
Section Plat

Rooks County, Sec. 11 Twp. 9 Rge. (E) 17 (W)
Location as "NE/CNW/SE" or footage from lines NW - NE - SE
Lease Owner Frank J. Black
Lease Name Westhusin "A" Well No. 1
Office Address McPherson, Kansas
Character of Well (completed as Oil, Gas or Dry Hole) Oil
Date well completed July 21 19 48
Application for plugging filed August 6 19 58
Application for plugging approved August 7 19 58
Plugging commenced August 20 19 58
Plugging completed August 27 19 58
Reason for abandonment of well or producing formation Unprofitable

If a producing well is abandoned, date of last production 19
Was permission obtained from the Conservation Division or its agents before plugging was commenced? Yes

Name of Conservation Agent who supervised plugging of this well Eldon Petty
Producing formation Depth to top Bottom Total Depth of Well 3414 Feet
Show depth and thickness of all water, oil and gas formations.

OIL, GAS OR WATER RECORDS

CASING RECORD

FORMATION	CONTENT	FROM	TO	SIZE	PUT IN	PULLED OUT
				10 3/4	102	None
				5 1/2	3408	2706.34

Describe in detail the manner in which the well was plugged, indicating where the mud fluid was placed and the method or methods used in introducing it into the hole. If cement or other plugs were used, state the character of same and depth placed, from feet to feet for each plug set.

Sanded hole to 3400' - dumped 4 sks cement - pulled pipe to 725' - pumped 50 sks Jel Mud through casing - couldn't get circulation - pulled casing to 600' - pumped 5 more sks Jel Mud - got mud return - spotted 20 sks cement through casing - pulled casing up to 160' - spotted 20 sks more of cement through casing - finished pulling casing - bailed mud out of callar and surface pipe to 25' - set rock bridge - dumped 10 sks cement.

SEP 7 1958
9-3-1958

(If additional description is necessary, use BACK of this sheet)
Name of Plugging Contractor R & D Casing Pulling Company License # 236
Address Box 569 Ellinwood, Kansas

STATE OF KANSAS, COUNTY OF MCPHERSON, ss.
Frank J. Black (employee of owner) or (owner or operator) of the above-described well, being first duly sworn on oath, says: That I have knowledge of the facts, statements, and matters herein contained and the log of the above-described well as filed and that the same are true and correct. So help me God.

(Signature) *Frank J. Black*

(Address)

SUBSCRIBED AND SWORN TO before me this 2nd day of Sept, 1958

My commission expires Sep 15, 1962 Notary Public.

PLUGGING
FILE SEC 11 T 9 R 17W
BOOK PAGE 121 LINE 11


WELL LOG BUREAU KANSAS GEOLOGICAL SOCIETY
508 E. Murdock Wichita, Kansas

Company DELTA & HARBAR DRILLING CO.
Farm Westhusin "A" No. -1

SEC. 11 T. 9 R. 17W
NW NE SE

Total Depth. 3414
Comm. 6-4-48 Comp. 7-21-48
Shot or Treated.
Contractor.
Issued. 4-15-50

County. Rooks
KANSAS

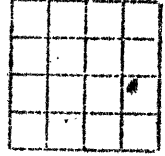

Elevation. _____

Production. 954 bbls.

CASING:
10 3/4" 102' cem w/100 sx
5 1/2" 3408' cem w/100 sx

Figures Indicate Bottom of Formations.

clay & shale	40
shale & shells	55
sand	70
shale & shells	505
sand	570
shale, shells & salt	1045
shale & redbed	1255
anhydrite	1295
shale & redbed	1745
anhydrite	1795
shale & shells	1885
shale & lime	2170
lime	2260
lime & shale	2840
lime	3414
Total depth	

Tops:

Topeka	2875
Hoebner	3090
Toronto	3112
Lansing	3130
B. K.C.	3323
Arbuckle	3408

FILED
STATE
9-3-1958

PLUGGING
FILE SEC. 11 T. 9 R. 17W
BOOK PAGE 121 LINE 11