


STATE OF KANSAS
STATE CORPORATION COMMISSION

Give All Information Completely
Make Required Affidavit
Mail or Deliver Report to:
Conservation Division
State Corporation Commission
212 North Market, Insurance Bldg.
Wichita, Kansas

WELL PLUGGING RECORD

NORTH

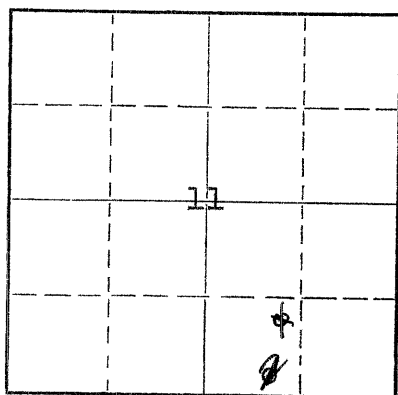

Locate well correctly on above
Section Plat

Rooks County, Sec. 11 Twp. 9 Rge. (E) 17 (W)

Location as "NE/CNW $\frac{1}{2}$ SW $\frac{1}{2}$ " or footage from lines NE SE SW SE
Lease Owner Cooperative Refinery Association
Lease Name Westhusin Well No. 9
Office Address Drawer C, Great Bend, Kansas
Character of Well (completed as Oil, Gas or Dry Hole) Oil
Date well completed July 2, 19 58
Application for plugging filed January 28, 19 64
Application for plugging approved Verbal approval Jan. 22 19 64
Plugging commenced January 23, 19 64
Plugging completed January 24, 19 64
Reason for abandonment of well or producing formation Casing leak could not be repaired.

If a producing well is abandoned, date of last production January 8, 19 62
Was permission obtained from the Conservation Division or its agents before plugging was commenced? Yes

Name of Conservation Agent who supervised plugging of this well Eldon Petty
Producing formation Lansing-Kansas City Depth to top 3152 Bottom 3380 Total Depth of Well 3465 Feet
Show depth and thickness of all water, oil and gas formations.

OIL, GAS OR WATER RECORDS

CASING RECORD

FORMATION	CONTENT	FROM	TO	SIZE	PUT IN	PULLED OUT
Dakota Sand	Water	500	1000	8-5/8	208	None
Lansing-Kansas City	Oil	3152	3380	5-1/2	3464	None

Describe in detail the manner in which the well was plugged, indicating where the mud fluid was placed and the method or methods used in introducing it into the hole. If cement or other plugs were used, state the character of same and depth placed, from _____ feet to _____ feet for each plug set.

Placed 60 sacks of HA-5 Quickset cement through tubing from 1150 feet to 730 feet. Raised tubing to 580 feet. Mud from 730 feet to 580 feet. Placed 20 sacks of cement from 580 feet to 440 feet. Raised tubing to 140 feet. Mud from 440 feet to 140 feet. Circulated 20 sacks of cement 140 feet to surface. Pulled tubing and waited 24 hours on cement. Cement settled to 25 feet. Filled with cement from 25 feet to 3 feet. Cut off pipe at three feet.

RECEIVED
STATE CORPORATION COMMISSION

JAN 29 1964

1-29-1964
CONSERVATION DIVISION
Wichita, Kansas

Name of Plugging Contractor Halliburton Oil Well Cementing Company
Address Hays, Kansas

STATE OF Kansas, COUNTY OF Barton, ss. Paul M. Goodwin

(employee of owner) or ~~owner or operator~~ of the above-described well, being first duly sworn on oath, says: That I have knowledge of the facts, statements, and matters herein contained and the log of the above-described well as filed and that the same are true and correct. So help me God.

(Signature) Paul M. Goodwin
Drawer C, Great Bend, Kansas
(Address)

SUBSCRIBED AND SWORN TO before me this 28th day of January, 19 64

My commission expires April 17, 1966

Notary Public.



DRILLERS' LOG

Well Owner: Plainstock Oil Company
Farm Name: Westhusin Well No. 9
Commenced: 6/23/58
Completed: 7/2/58
Total Depth: 3465'
Casing: 8 5/8" @ 208' cemented
5 1/2" @ 3464' cemented

NE SW SE
Sec. 11-9S-17W
Rooks County, Kansas
Elevation:
Production:

Contractor: Peel Brothers, Inc.

Figures below indicate bottoms of formations:

Shale and sand	375
Shale	500
Shale and sand	700
Shale	875
Sand	1000
Shale	1275
Anhydrite	1325
Shale	1770
Shale and lime	1960
Lime	2085
Shale and lime	2520
Lime	2620
Lime and shale	2955
Lime	3435
Cong.	3465
Total Depth	3465

RECEIVED
OCT 10 1958
1-29-1964
CONSERVATION DIVISION
Wichita, Kansas

This is to certify that the above information is to the best of our knowledge, true and correct.

PEEL BROTHERS, INC.

BY [Signature]

SUBSCRIBED AND SWORN to before me this 3rd day of July, 1958

My commission expires: April 27, 1960

[Signature]
Notary Public