

15-163-01107-00-01

STATE OF KANSAS  
STATE CORPORATION COMMISSION


WELL PLUGGING RECORD

Give All Information Completely  
Make Required Affidavit  
Mail or Deliver Report to:  
Conservation Division  
State Corporation Commission  
800 Bitting Building  
Wichita, Kansas

OR  
FORMATION PLUGGING RECORD

Strike out upper line  
when reporting plug-  
ging off formations.

NORTH

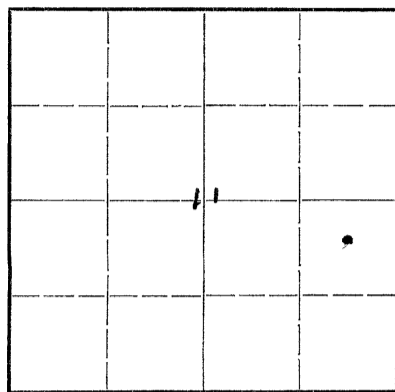

Locate well correctly on above  
Section Plat

Rooks County. Sec. 11 Twp. 9 S Rge. (E) 17(W)

Location as "NE $\frac{1}{4}$ NW $\frac{1}{4}$ SW $\frac{1}{4}$ " or footage from lines. C NE $\frac{1}{4}$  SE $\frac{1}{4}$

Lease Owner Plain - Stock Oil & Gas Co.

Lease Name J. R. Westhusin Well No. 1

Office Address Plainville, Kansas

Character of Well (completed as Oil, Gas or Dry Hole) Oil

Date well completed November 19 19 36

Application for plugging filed May 22 19 45

Application for plugging approved May 23 19 45

Plugging commenced May 24 19 45

Plugging completed 19

Reason for abandonment of well or producing formation Dakota Water broke

through casing, flooded well, failed to get shut off

If a producing well is abandoned, date of last production March 30, 1945 19

Was permission obtained from the Conservation Division or its agents before plugging was com-  
menced? Yes

Name of Conservation Agent who supervised plugging of this well H. W. Kerr

Producing formation Kansas City Depth to top 3141 Bottom 3243 Total Depth of Well 3325 Feet

Show depth and thickness of all water, oil and gas formations.

OIL, GAS OR WATER RECORDS


CASING RECORD

Formation	Content	From	To	Size	Put In	Pulled Out
Sand	Water	468	473			
Sand	Water	498	510			
Sand	Water	530	600	10"	1278	From tpp 640
Topeka Lime	Oil	3042	3071	8"	2947	2198
Kansas City	Oil	3231	3243	7"	3148	3050

Describe in detail the manner in which the well was plugged, indicating where the mud fluid was placed and the method or methods used in introducing it into the hold. If cement or other plugs were used, state the character of same and depth placed, from \_\_\_\_\_ feet to \_\_\_\_\_ feet for each plug set.

Mud & Crushed rock 3325 to 1332  
 Set bridge & Crushed rock 1332 to 1326  
 Dumped 25 sax cement 1326 to 1295  
 Mud 1295 to 500  
 Set bridge & crushed rock 500 to 492  
 Dumped 10 sax cement 492 to 482  
 Mud 482 to 18  
 Set bridge, dumped 10 sax cement 18 to 10 Bottom of cellar

PLUGGING  
FILE REC-11-9-R-124  
BOOK PAGE 13 LINE 29

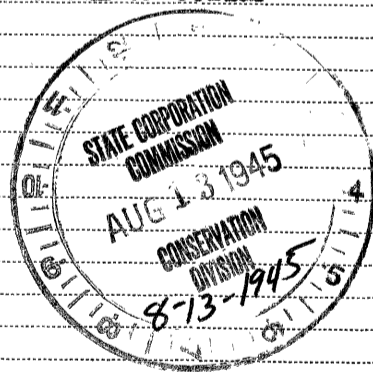

(If additional description is necessary, use BACK of this sheet)

Correspondence regarding this well should be addressed to Plain - Stock Oil & Gas Co.  
Address Plainville, Kansas.

STATE OF KANSAS, COUNTY OF ROOKS, ss.  
C. C. Reeves (employee of owner) or (owner) of the above-described well,

being first duly sworn on oath, says: That I have knowledge of the facts, statements, and matters herein contained and the log of the above-described well as filed and that the same are true and correct. So help me God.

(Signature) C. C. Reeves

Plainville, Kansas (Address)

SUBSCRIBED AND SWORN TO before me this 11th day of August, 19 45

My commission expires Sept. 28, 1947

Betha A. Wine Notary Public.