

STATE OF KANSAS
STATE CORPORATION COMMISSION


WELL PLUGGING RECORD

Give All Information Completely
Make Required Affidavit
Mail or Deliver Report to:
Conservation Division
State Corporation Commission
800 Biting Building
Wichita, Kansas

OR
FORMATION PLUGGING RECORD

Strike out upper line
when reporting plugging
off formations.

NORTH

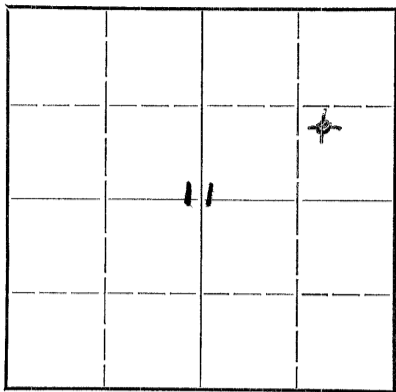

Locate well correctly on above
Section Plat

Rooks _____ County. Sec. 11 Twp. 9 Rge. 17 (W)
Location as "NE $\frac{1}{4}$ NW $\frac{1}{4}$ SW $\frac{1}{4}$ " or footage from lines NW-SE-NE
Lease Owner A. H. Kasishke
Lease Name John Westhusin Well No. 2
Office Address 929 Kennedy Building, Tulsa, Oklahoma
Character of Well (completed as Oil, Gas or Dry Hole) Dry Hole
Date well completed Nov. 4, 1948 19__
Application for plugging filed November 6, 19__ 48
Application for plugging approved do 19__ 48
Plugging commenced do 19__ 48
Plugging completed do 19__ 48
Reason for abandonment of well or producing formation Dry Hole
If a producing well is abandoned, date of last production _____ 19__

Was permission obtained from the Conservation Division or its agents before plugging was commenced? yes

Name of Conservation Agent who supervised plugging of this well M. A. Rives
Producing formation _____ Depth to top _____ Bottom _____ Total Depth of Well 3448 Feet

Show depth and thickness of all water, oil and gas formations.

OIL, GAS OR WATER RECORDS

CASING RECORD

Formation	Content	From	To	Size	Put In	Pulled Out

Describe in detail the manner in which the well was plugged, indicating where the mud fluid was placed and the method or methods used in introducing it into the hold. If cement or other plugs were used, state the character of same and depth placed, from _____ feet to _____ feet for each plug set.

Total Depth 3448'
8 5/8" Surface Pipe set @ 581'
3448' to 250' Heavy Mud
250' to 200' Plug and Cement
200' to 30' Heavy Mud
30' to 0' Plug and Cement

[Handwritten signature]
NOV 20 1948
ST. *[Handwritten initials]*

(If additional description is necessary, use BACK of this sheet)
Correspondence regarding this well should be addressed to Alkay Oil Company
Address 929 Kennedy Building, Tulsa, Oklahoma

STATE OF Oklahoma, COUNTY OF Tulsa, ss.
H. C. Shelton (employee of owner) or (owner or operator) of the above-described well,
being first duly sworn on oath, says: That I have knowledge of the facts, statements, and matters herein contained and the log of the above-described well as filed and that the same are true and correct. So help me God.

(Signature) *[Handwritten Signature: H. C. Shelton]*
929 Kennedy Building, Tulsa, Oklahoma
(Address)

SUBSCRIBED AND SWORN TO before me this 19 day of November, 19__ 48
[Handwritten Signature: W. Otis Smith]
Notary Public.

My commission expires Dec. 13, 1951

PLUGGING
FILE SEC 4 T 9 R 7 W
BOOK PAGE 67 LINE 12

WELL LOG

ALRAY OIL COMPANY # 2 WESTHUSIN
 NW 3/4 NE 11-9S-17W
 Rocks County, Kansas

Elev. Ground 1998'
 Kelly Dushing 2006'
 All Measurements from K. B.

Commenced 10-23-48, Completed 11-4-48
 Casing Record 561 @ 5/8" 350 Max Cement

FROM	TO	
0	340	Shale
340	400	Sandy Shale-Limestone
400	530	Sandy Shale-Line Streaks
530	565	Water Sand
565	573	Line & Pyrite
573	990	Sand & Shale
990	1130	Red Bed
1130	1252	Shale
1252	1300	Anhydrite
1300	1340	Red Bed & Shale
1340	1640	Shale & Shells
1640	1730	Shale & Salt
1730	1750	Shale & Shells
1750	2005	Line & Shale
2005	2080	Broken Line
2080	2240	Line
2240	2540	Broken Line
2540	2680	Line & Shale
2680	2930	Shale & Shells
2930	3441	Line - D. S. T. 3441' - No Results
3441	3448	Conglomerate
	3448	T. D.

11-20-1948

