


WELL PLUGGING RECORD

Give All Information Completely  
Make Required Affidavit  
Mail or Deliver Report to:  
Conservation Division  
State Corporation Commission  
212 No. Market  
Wichita, Kansas

NORTH

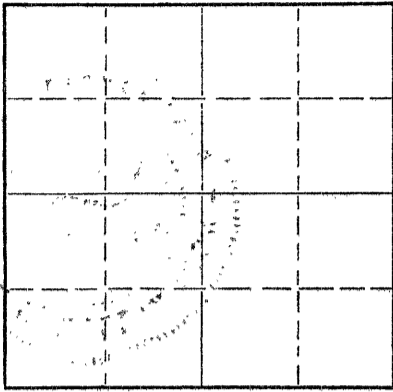

Locate well correctly on above Section Plat

Rooks County, Sec. 17 Twp. 9S Rge. 17 (W)

Location as "NE/CNW/SW" or footage from lines. Approx C NW/4 NE/4 NE/4  
Lease Owner ~~Mahoney Drilling Company, Inc.~~ MALLONEE-MAHONEY, INC.

Lease Name Keas Well No. 1

Office Address Box 1257, Liberal, Kansas 67801

Character of Well (completed as Oil, Gas or Dry Hole) Dry Hole

Date well completed 6-28 1968

Application for plugging filed 6-28 1968

Application for plugging approved 6-28 1968

Plugging commenced 6-28 1968

Plugging completed 6-28 1968

Reason for abandonment of well or producing formation Dry Hole

If a producing well is abandoned, date of last production 19

Was permission obtained from the Conservation Division or its agents before plugging was commenced? Yes

Name of Conservation Agent who supervised plugging of this well Leo Massey

Producing formation \_\_\_\_\_ Depth to top \_\_\_\_\_ Bottom \_\_\_\_\_ Total Depth of Well \_\_\_\_\_ Feet

Show depth and thickness of all water, oil and gas formations.

OIL, GAS OR WATER RECORDS

CASING RECORD

FORMATION	CONTENT	FROM	TO	SIZE	PUT IN	PULLED OUT

RECEIVED  
STATE CORPORATION COMMISSION  
JUL 8 1968  
CONSERVATION DIVISION  
Wichita, Kansas  
07-08-1968

Describe in detail the manner in which the well was plugged, indicating where the mud fluid was placed and the method or methods used in introducing it into the hole. If cement or other plugs were used, state the character of same and depth placed, from \_\_\_\_\_ feet to \_\_\_\_\_ feet for each plug set.

3516 - 660 - Heavy rotary mud  
660 - 660 - HB plug, 70 sacks 50-50 Halco, 6% Gel  
660 - 240 - Heavy rotary mud  
240 - 240 - HB plug, 20 sacks 50-50 Halco, " "  
240 - 40 - Heavy rotary mud  
40 - 40 - HB plug, 10 sacks " " " "

(If additional description is necessary, use BACK of this sheet)

Name of Plugging Contractor Peel Brothers, Inc.

Address Box 359, Hoisington, Kansas 67544

STATE OF Kansas, COUNTY OF Barton, ss.

Peel Brothers, Inc. (employee of owner) ~~owner or operator~~ of the above-described well, being first duly sworn on oath, says: That I have knowledge of the facts, statements, and matters herein contained and the log of the above-described well as filed and that the same are true and correct. So help me God.


(Signature) Wendell C. Peel  
Wendell C. Peel, President

(Address)

SUBSCRIBED AND SWORN TO before me this 2nd day of July, 19 68

My commission expires 6-21-70

Ethel S. Williamson  
Ethel S. Williamson  
Notary Public.

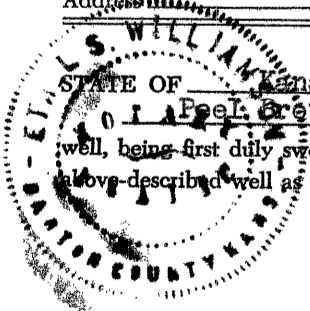

15-163-20114-00-00

DRILLER'S LOG

MALLONEE-MAHONEY, INC.

Well Owner: ~~Mahoney Drilling Company, Inc.~~  
Farm Name: Keas #1  
Date Started: 6-20-68  
Date Completed: 6-28-68  
Total Depth: 3516'

Section 17-9S-17W  
Rooks County, Kansas

Casing: 8-5/8" set at 250' cemented

Contractor: Peel Brothers, Inc.

Figures below are the bottoms of the formations:

Surface Clay	0 - 190
Shale	695
Sand	1085
Red Bed	1300
Anhydrite	1408
Shale and Shells	1545
Shale and Lime	2174
Lime and Shale	3055
Lime	3516
Total Depth	3516

RECEIVED  
STATE CORPORATION COMMISSION  
JUL 8 1968  
CONSERVATION DIVISION  
Wichita, Kansas

This is to certify that the above information is true and correct to the best of our knowledge.

PEEL BROTHERS, INC.

*Wendell C. Peel*  
Wendell C. Peel  
President



SUBSCRIBED AND SWORN to before me this 2nd day of July, 1968.

*Ethel S. Williamson*  
Ethel S. Williamson  
Notary Public

My Commission expires 6-21-70