


15-163-00392-00-00

STATE OF KANSAS  
STATE CORPORATION COMMISSION

WELL PLUGGING RECORD

Give All Information Completely  
Make Required Affidavit  
Mail or Deliver Report to:  
Conservation Division  
State Corporation Commission  
800 Bitting Building  
Wichita, Kansas

Rooks County, Sec. 17 Twp. 10S Rge. 18 ~~25S~~ (W)  
Location as "NE/CNW $\frac{1}{4}$ SW $\frac{1}{4}$ " or footage from lines NW/4 NW/4 NE/4  
Lease Owner Heathman Drilling Co., Inc., et al  
Lease Name TEALL Well No. 2  
Office Address 509 Orpheum Building, Wichita, Kansas  
Character of Well (completed as Oil, Gas or Dry Hole) dry hole  
Date well completed 7-22-1950  
Application for plugging filed 8-9-50 (written)(verbal) - - - - 8-3-1950  
Application for plugging approved 8-7-50 (written)(verbal) - - - - 8-3-1950  
Plugging commenced 8-3-1950  
Plugging completed 8-3-1950  
Reason for abandonment of well or producing formation - - - - dry hole - - - -

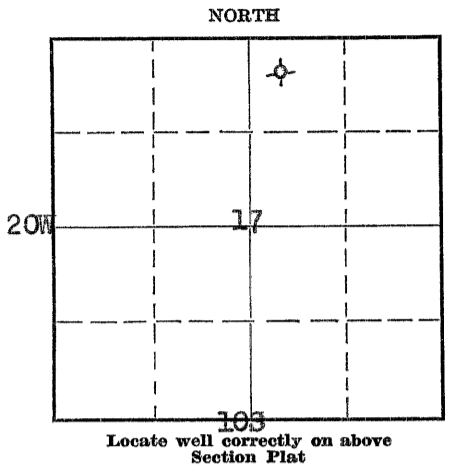

If a producing well is abandoned, date of last production - - - - - 19 - - - -  
Was permission obtained from the Conservation Division or its agents before plugging was commenced? YES

Name of Conservation Agent who supervised plugging of this well Eldon Patty, Box 326, Hays, Kansas  
Producing formation - - - - - Depth to top - - - - - Bottom - - - - - Total Depth of Well 3875 Feet  
Show depth and thickness of all water, oil and gas formations.

OIL, GAS OR WATER RECORDS

CASING RECORD

Formation	Content	From	To	Size	Put In	Pulled Out
none	-	-	-	8-5/8" 28#	new cemented	none
				@ 127' w/100 sacks.		

Describe in detail the manner in which the well was plugged, indicating where the mud fluid was placed and the method or methods used in introducing it into the hole. If cement or other plugs were used, state the character of same and depth placed, from - - - - - feet to - - - - - feet for each plug set.

Set plug @ 125' and 10 sacks cement - plugged 10:00 P.M. 8-3-50

08-10-1950

(If additional description is necessary, use BACK of this sheet)


Correspondence regarding this well should be addressed to  
Address Heathman Drilling Co., Inc., 509 Orpheum Bldg., Wichita, Kansas

STATE OF Kansas, COUNTY OF Sedgwick, ss.  
Robert F. Walters (employee of owner) ~~or former owner~~ of the above-described well,  
being first duly sworn on oath, says: That I have knowledge of the facts, statements, and matters herein contained and the log of the above-described well as filed and that the same are true and correct. So help me God.

(Signature) Robert F. Walters  
509 Orpheum Bldg., Wichita, Kansas  
(Address)

SUBSCRIBED AND SWORN to before me this 9th day of August, 1950

My commission expires June 28, 1952  
D. Marjorie Matt Notary Public.

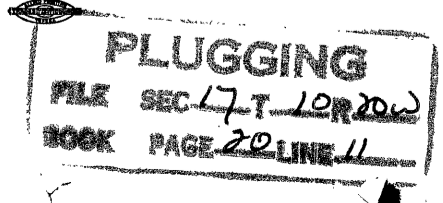

15-163-00392-00-00

TEALL NO. 2 WELL

Location:	NW/4 NW/4 NE/4 Sec.17-10S-20W Rooks County, Kansas	Spudded:	7-22-50
Operator:	Heathman Drilling Co., Inc.	Completed:	8-3-50
Contractor:	Heathman Drilling Co., Inc.	Elevation:	2252 Gr; 2254 DF 2256 KB
Surface casing:	6 jts. (132') 8-5/8" new 28# cemented @ 127' w/100 sacks cement.		
Oil String:	None - D&A		

T O P S (KB)

Anhydrite	1741 (+ 515)
Topeka	3293 (-1037)
Heebner	3498 (-1242)
Lansing-Kansas City	3538 (-1282)
Base Kansas City	3764 (-1508)
Conglomerate	3806 (-1550)
Simpson	3835 (-1579)
Arbuckle	3850 (-1594)
Rotary Total Depth	3875 (-1619)

L O G

(Figures indicate bottom of formation.)

Sand and shale	0 to 130
Shale and sand	160
Shale	795
Shale and sand	1125
Shale	1170
Sand	1420
Shale and shells	1741
Anhydrite	1781
Shale and shells	2144
Shale - lime	2930
Shale	3236
Lime - shale	3352
Lime	3490
Lime - shale	3510
Lime	3856
Lime and chert	3875
Total Depth	3875'

08-10-1950

The undersigned, Robert F. Walters of the Heathman Drilling Co., Inc., hereby certifies that the above is a true and correct log of the formations encountered in drilling the Teall #2 well as shown on the daily drilling reports.

HEATHMAN DRILLING CO., INC.

BY: Robert F. Walters

Subscribed and sworn to before me  
this 9th day of August, 1950.

D. Marguerite Mott  
Notary Public

My commission expires: June 28, 1952.

