


STATE OF KANSAS
STATE CORPORATION COMMISSION

Give All Information Completely
Make Required Affidavit
Mail or Deliver Report to:
Conservation Division
State Corporation Commission
211 No. Broadway
Wichita, Kansas

15-163-00986-00-00

WELL PLUGGING RECORD

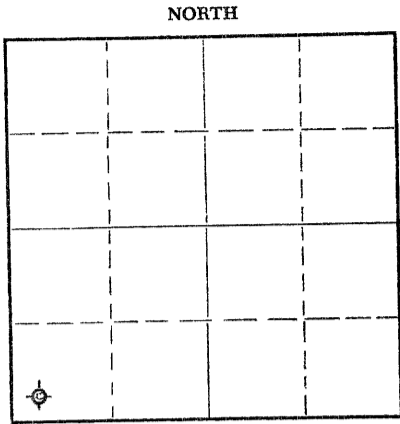

Locate well correctly on above Section Plat

Rooks County, Sec. 17 Twp. 10 Rge. 20 (E) W (W)
Location as "NE/CNW/SW" or footage from lines SW SW SW
Lease Owner D. G. Hansen & C-G Drilling Co.
Lease Name Desbien Well No. 1
Office Address 107 Rule Bldg., Wichita, Kansas
Character of Well (completed as Oil, Gas or Dry Hole) Dry Hole
Date well completed August 4 19 56
Application for plugging filed August 4 19 56
Application for plugging approved August 4 19 56
Plugging commenced August 5 19 56
Plugging completed August 5 19 56
Reason for abandonment of well or producing formation Too low structurally

If a producing well is abandoned, date of last production _____ 19____
Was permission obtained from the Conservation Division or its agents before plugging was commenced? Yes

Name of Conservation Agent who supervised plugging of this well _____
Producing formation _____ Depth to top _____ Bottom _____ Total Depth of Well 3808 Feet
Show depth and thickness of all water, oil and gas formations.

OIL, GAS OR WATER RECORDS

CASING RECORD

FORMATION	CONTENT	FROM	TO	SIZE	PUT IN	PULLED OUT
				8-5/8"	185'	none

Describe in detail the manner in which the well was plugged, indicating where the mud fluid was placed and the method or methods used in introducing it into the hole. If cement or other plugs were used, state the character of same and depth placed, from _____ feet to _____ feet for each plug set.

Filled hole with heavy mud to 180'. Set plug. Put in 1/2 sack Hulls and 15 sacks cement. Filled with heavy mud up to 40'. Set plug. Filled to top with 1/2 sack Hulls and 10 sacks cement.

(If additional description is necessary, use BACK of this sheet)

Name of Plugging Contractor C-G Drilling Co.
Address 107 Rule Bldg., Wichita, Kansas

STATE OF KANSAS, COUNTY OF SEDGWICK, ss.
G. F. Galloway (employee of owner) or (owner or operator) of the above-described well, being first duly sworn on oath, says: That I have knowledge of the facts, statements, and matters herein contained and the log of the above-described well as filed and that the same are true and correct. So help me God.

(Signature) G. F. Galloway
107 Rule Bldg.
(Address)

SUBSCRIBED AND SWORN TO before me this 7th day of August, 19 56

My commission expires May 20, 1959

Vicky Jacobs
Vicky Jacobs Notary Public.

PLUGGING
FILE SEC 17 T. 10 R. 20W
BOOK PAGE 87 LINE 42

RECEIVED
STATE CORPORATION COMMISSION
AUG 9 1956
08-09-1956
CONSERVATION DIVISION
Wichita, Kansas

15-103-00986-00-00

CONTRACTOR'S WELL LOG

OPERATOR D. G. HANSEN & C-G DRILLING CO.

WELL NAME DESBIEN #1

LOCATION SW SW SW SECTION 17-10-20W

RIG NO. 1

COUNTY ROOKS

STATE KANSAS

COMMENCEMENT DATE JULY 27, 1956

COMPLETION DATE AUGUST 4, 1956

LOG OF WELL

Elevation 2143 rotary bushing.
All measurements taken from rotary bushing.

FROM	TO	FORMATION	DEVIATION FROM VERTICAL	REMARKS
0	140	Surface Soil		
140	700	shale		
700	860	Sand		
860	1120	Sand-Shale		
1120	1150	Sand		
1150	1360	Sand		
1360	1644	Red Bed		
1644	1684	Anhydrite		
1684	1730	Shale		
1730	2160	Shale-Shells		
2160	2315	Lime-Shale		
2315	2475	Lime-Shale		
2475	2555	Lime-Shale		
2555	2635	Lime-Shale	0° - 2500	
2635	2815	Lime-Shale		
2815	2925	Lime-Shale	0° - 2750	
2925	3020	Lime-Shale		
3020	3160	Lime-Shale	0° - 3000	
3160	3255	Lime-Shale		
3255	3342	Lime-Shale	0° - 3250	
3342	3445	Lime-Shale		
3443	3550	Lime-Shale		
3550	3650	Lime-Shale	0° - 3500	
3650	3705	Lime-Shale		
3705	3770	Lime-Shale		
3770	3808	Lime-Shale	0° - 3750	

CASING LEFT IN HOLE AFTER COMPLETION

Set 185' of 8-5/8" OD Surface Casing.

COUNTY OF SEDGWICK }
STATE OF KANSAS } SS.

The undersigned hereby certifies that to the best of his knowledge and belief, the above facts are true and correct.

C-G DRILLING CO.

By G. F. Galloway

Subscribed and sworn to before me this 6th day of August, 1956.

My commission expires: August 20, 1959

Vicky Jacobs
Vicky Jacobs, Notary Public

PLUGGING
FILE SEC 17 T 10 R 20W
BOOK PAGE 87 LINE 42

RECEIVED
COMMISSIONER OF GEOL. & MINES
08-09-1956
CONSERVATION DIVISION
Wichita, Kansas