


WELL PLUGGING RECORD

Give All Information Completely  
Make Required Affidavit  
Mail or Deliver Report to:  
Conservation Division  
State Corporation Commission  
800 Biting Building  
Wichita, Kansas

Books \_\_\_\_\_ County. Sec. 17 Twp. 10s Rge. (E) 20(W)

Location as "NE/CNW $\frac{1}{4}$ SW $\frac{1}{4}$ " or footage from lines. S. 17 - 10 - 20  
Lease Owner Champlin Refining Company  
Lease Name Martin P. Sutor Well No. 1  
Office Address P.O. Drawer #552, Enid, Oklahoma  
Character of Well (completed as Oil, Gas or Dry Hole) Dry Hole  
Date well completed February 20 19 53  
Application for plugging filed February 20 19 53  
Application for plugging approved February 20 (Verball) 19 53  
Plugging commenced February 20 19 53  
Plugging completed February 20 19 53  
Reason for abandonment of well or producing formation \_\_\_\_\_

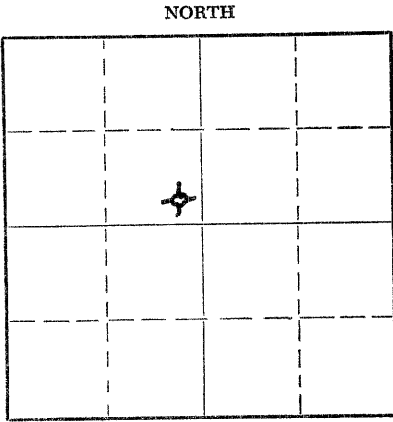

Locate well correctly on above Section Plat

If a producing well is abandoned, date of last production \_\_\_\_\_ 19 \_\_\_\_\_  
Was permission obtained from the Conservation Division or its agents before plugging was commenced? Yes

Name of Conservation Agent who supervised plugging of this well Mr. Eldon Petty  
Producing formation \_\_\_\_\_ Depth to top \_\_\_\_\_ Bottom \_\_\_\_\_ Total Depth of Well \_\_\_\_\_ Feet  
Show depth and thickness of all water, oil and gas formations.

OIL, GAS OR WATER RECORDS

CASING RECORD

FORMATION	CONTENT	FROM	TO	SIZE	PUT IN	PULLED OUT
				8 5/8" CD	148'	None

Describe in detail the manner in which the well was plugged, indicating where the mud fluid was placed and the method or methods used in introducing it into the hole. If cement or other plugs were used, state the character of same and depth placed, from \_\_\_\_\_ feet to \_\_\_\_\_ feet for each plug set.

Filled hole with heavy rotary mud from 3875' T.D. to 150' and set Halliburton plug at 150' and pumped in 15 sacks of cement on top of plug then filled hole from top of cement to 40' and set Halliburton plug at 40' and pumped in ten sacks of cement to fill hole from 40' to bottom of cellar.

(If additional description is necessary, use BACK of this sheet)


Name of Plugging Contractor Champlin Refining Company (Rotary tools)  
Address P.O. Drawer #552, Enid, Oklahoma

STATE OF Kansas, COUNTY OF Barton, ss.  
S. P. Hall (employee of owner) or (~~owner or operator~~) of the above-described well, being first duly sworn on oath, says: That I have knowledge of the facts, statements, and matters herein contained and the log of the above-described well as filed and that the same are true and correct. So help me God.

(Signature) S. P. Hall  
P.O. Box 167, Ellinwood, Kansas  
(Address)

SUBSCRIBED AND SWORN TO before me this 26th day of February, 19 53.  
N. Kenneth Stover  
Notary Public.

My commission expires Sept. 10, 1955

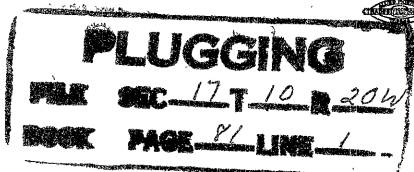

02-27-1953

CHAMPLIN DRILLING COMPANY

Martin P. Sutor  
 2310' from the North Line  
 and 2310' from the West Line  
 of the Northwest Quarter  
 (N<sub>W</sub>/4) of Section 17-10S-20W,  
 Rocks County, Kansas.

0'-156'	Clay & Sand
156'-370'	Shale & Shells
370'-740'	Shale Shells & Sand
740'-1525'	Red Bed Shells & Sand
1525'-1710'	Shale & Sand
1710'-1755'	Anhydrite
1755'-1760'	Shale & Shells
1760'-2080'	Shale & Shells
2080'-2315'	Shale & Shells
2315'-2470'	Shale & Lime
2470'-2600'	Shale & Lime
2600'-2705'	Shale & Lime
2705'-2825'	Shale & Lime
2825'-2960'	Shale & Lime
2960'-3070'	Shale & Lime
3070'-3137'	Shale & Lime
3137'-3220'	Shale & Lime
3220'-3335'	Shale & Lime
3335'-3402'	Shale & Lime
3402'-3445'	Shale & Lime
3445'-3500'	Shale & Lime
3500'-3536'	Shale & Lime
3536'-3580'	Shale & Lime
3580'-3640'	Shale & Lime
3640'-3677'	Shale & Lime
3677'-3715'	Shale & Lime
3715'-3770'	Shale & Lime
3770'-3824'	Conglomerate
3824'-3872'	Conglomerate
3872'-3875'	Conglomerate
3875'	Total Depth

02-23-1953


