


WELL PLUGGING RECORD

Give All Information Completely  
Make Required Affidavit  
Mail or Deliver Report to:  
Conservation Division  
State Corporation Commission  
800 Bitting Building  
Wichita, Kansas

NORTH

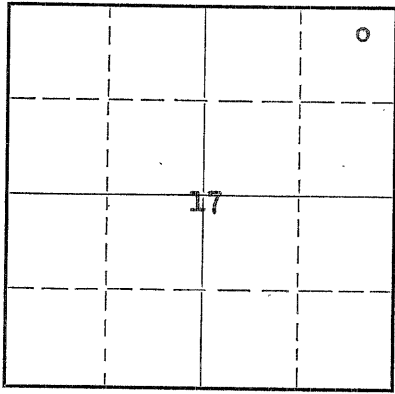

Locate well correctly on above  
Section Plat

Rooks County. Sec. 17 Twp. 10 Rge. 20W (E) (W)  
Location as "NE/CNW $\frac{1}{4}$ SW $\frac{1}{4}$ " or footage from lines NE $\frac{1}{4}$  NE $\frac{1}{4}$  NE $\frac{1}{4}$   
Lease Owner Heathman Drilling Co., Inc.  
Lease Name Teall Well No. 1  
Office Address 509 Orpheum Bldg., Wichita, Kansas  
Character of Well (completed as Oil, Gas or Dry Hole) dry hole  
Date well completed May 9, 1950  
Application for plugging filed May 9, 1950  
Application for plugging approved May 9, 1950  
Plugging commenced May 9, 1950  
Plugging completed May 9, 1950  
Reason for abandonment of well or producing formation

If a producing well is abandoned, date of last production 19...  
Was permission obtained from the Conservation Division or its agents before plugging was commenced? yes

Name of Conservation Agent who supervised plugging of this well Eldon Petty  
Producing formation Depth to top Bottom Total Depth of Well 39.31 Feet  
Show depth and thickness of all water, oil and gas formations.

OIL, GAS OR WATER RECORDS

CASING RECORD

Formation	Content	From	To	Size	Put In	Pulled Out
				Ran 6 jts., 156.92' of 8-5/8" casing cemented @ 155' with 135 sacks bulk cement & 1 c.c.		

Describe in detail the manner in which the well was plugged, indicating where the mud fluid was placed and the method or methods used in introducing it into the hole. If cement or other plugs were used, state the character of same and depth placed, from feet to feet for each plug set.

Filled hole with heavy mud to 150' of top, 15 sacks cement on bottom plug at 150'; 10 sacks on top plug 35' below ground level.

05-17-1950

(If additional description is necessary, use BACK of this sheet)

Correspondence regarding this well should be addressed to Heathman Drilling Co., Inc.  
Address 509 Orpheum Building  
Wichita 2, Kansas

STATE OF KANSAS, COUNTY OF SEDGWICK  
Richard Hindery, partner of Birmingham-Bartlett Drilling Co. contractor, being first duly sworn on oath, says: That I have knowledge of the facts, statements, and matters herein contained and the log of the above-described well as filed and that the same are true and correct. So help me God.

(Signature) Richard Hindery  
300 Kaufman Bldg., Wichita, Kansas  
(Address)

SUBSCRIBED AND SWORN to before me this 11th day of May, 1950  
Virian J. Ginger Notary Public.

My commission expires November 29, 1950.

PLUGGING  
FILE SEC 17 T 10 R 20W  
BOOK PAGE 5 LINE 22

15-163-04096-0000

TEALL NO. 1

LOCATION: NE $\frac{1}{4}$  NE $\frac{1}{4}$  NE $\frac{1}{4}$  Sec. 17-10S-20W Rooks County, Kansas  
OPERATOR: Heathman Drilling Co., Inc.  
CONTRACTOR: Birmingham-Bartlett Drilling Co.  
SURFACE CASING: Ran 6 jts., 156.92' 8-5/8" casing cemented at 155' with 135 sacks bulk cement and 1 c.c.  
OIL STRING: None. D & A.

SPUDED: 5-1-50

COMPLETED: 5-9-50

L O G

(Figures indicate bottom of formation)

0 to	145	Surface sand and shale
	730	Shale
	940	Shale and shells
	1030	Shale and sand
	1120	Shale
	1145	Sand and shale
	1240	Shale
	1485	Sand
	1747	Red bed and shale
	1784	Anhydrite
	2225	Shale
	2400	Shale and shells
	2595	Shale and lime
	2850	Shale
	2960	Shale and lime shells
	3125	Shale
	3435	Shale and lime
	3830	Lime
	3931	Conglomerate
	3931	Total Depth

The undersigned Richard Hindery of the BIRMINGHAM-BARTLETT DRILLING CO. hereby certifies that the above is a true and correct log of the formations encountered in drilling the Teall No. 1 well as shown on the daily drilling reports.

BIRMINGHAM-BARTLETT DRILLING CO.

BY

Richard Hindery

Subscribed and sworn before me  
this 11th day of May, 1950.

Viriam L. Pinger  
Notary Public

My commission expires November 29, 1950.

05-17-1950  
MAY 17 1950

PLUGGING  
FILE SEC 17 T10 R20W  
BOOK PAGE 5 LINE 20