


WELL PLUGGING RECORD

Give Information Completely
Make Required Affidavit
Mail or Deliver Report to:
Conservation Division
State Corporation Commission
800 Bittling Building
Wichita, Kansas

Rooks County. Sec. 18 Twp. 10 Rge. 20 (E) W (W)
Location as "NE/CNW $\frac{1}{4}$ /SW $\frac{1}{4}$ " or footage from lines NE NE NW
Lease Owner C-G DRILLING CO.
Lease Name ZINK Well No. 1
Office Address 206 Union National Bank Bldg., Wichita, Kansas
Character of Well (completed as Oil, Gas or Dry Hole) Dry Hole
Date well completed February 15, 19 52
Application for plugging filed February 15, 19 52
Application for plugging approved February 15, 19 52
Plugging commenced February 15, 19 52
Plugging completed February 15, 19 52
Reason for abandonment of well or producing formation Too low structurally.

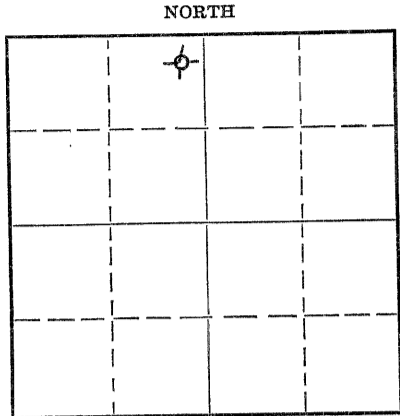

Locate well correctly on above Section Plat

If a producing well is abandoned, date of last production --- 19
Was permission obtained from the Conservation Division or its agents before plugging was commenced? Yes

Name of Conservation Agent who supervised plugging of this well Eldon Petty, Hays, Kansas
Producing formation --- Depth to top --- Bottom --- Total Depth of Well --- Feet
Show depth and thickness of all water, oil and gas formations.

OIL, GAS OR WATER RECORDS

CASING RECORD

Formation	Content	From	To	Size	Put In	Pulled Out
				8 5/8"	191.19'	

Describe in detail the manner in which the well was plugged, indicating where the mud fluid was placed and the method or methods used in introducing it into the hole. If cement or other plugs were used, state the character of same and depth placed, from --- feet to --- feet for each plug set.

Filled with drilling mud to 188'. Set plug. Put in 15 sacks cement and 1/2 sack hulls; pumped full of mud to 40'. Drove plug. Filled to top with 10 sacks cement and 1/2 sack hulls.

02-19-1952

(If additional description is necessary, use BACK of this sheet)

Name of Plugging Contractor C-G DRILLING CO.
Address 206 Union National Bank Building, Wichita, Kansas

STATE OF KANSAS, COUNTY OF SEDGWICK, ss.
VICKY FRITZ (employee of owner) or (owner or operator) of the above-described well,
being first duly sworn on oath, says: That I have knowledge of the facts, statements, and matters herein contained and the log of the above-described well as filed and that the same are true and correct. So help me God.

(Signature) Vicky Fritz, officiating
206 Union National Bank Bldg., Wichita, Kansas (Address)

SUBSCRIBED AND SWORN to before me this 18th day of February, 19 52

My commission expires 11/21/55

Marilyn Schmidt Notary Public.

PLUGGING
FILE SEC-13 T 10 R 20
BOOK PAGE 144 LINE 40

15-163-00611-00-00

CONTRACTOR'S WELL LOG

OPERATOR

C-G DRILLING CO.

FARM NAME

ZINK #1

LOCATION

NE NE NW Sec. 18-10-20W

POOL NAME

semi-wildcat

COUNTY

Rooks

STATE

Kansas

COMMENCEMENT DATE

2-5-52

COMPLETION DATE

2-15-52

LOG OF WELL

Elevation 2234 R. B.

All measurements from the top of rotary bushing.

FROM	TO	FORMATION	DEVIATION FROM VERTICAL	REMARKS:
0	191			
191	895	Shale-Sand		
895	960	Sand		
960	1225	Shale Shells-Sand		
1225	1355	Sand		
1355	1410	Sand		
1410	1742	Red Bed	0° - 1500'	
1742	1785	Anhydrite		
1785	1825	Shale		
1825	2200	Shale	0° - 2000'	
2200	2310	Lime-Shale		
2310	2440	Lime-Shale		
2440	2585	Shale-Lime	0° - 2500'	
2585	2685	Lime-Shale		
2685	2840	Lime-Shale		
2840	2940	Lime-Shale		
2940	3000	Lime-Shale	0° - 3000'	
3000	3120	Lime-Shale		
3120	3230	Lime-Shale		
3230	3380	Lime-Shale		
3380	3465	Lime-Shale		
3465	3520	Lime-Shale		
3520	3565	Lime		
3565	3615	Lime		
3615	3665	Lime		
3665	3720	Lime		
3720	3770	Lime		
3770	3825	Lime-Shale		
3825	3845	Conglomerate		
3845	3855	Lime		
3855	3885	Lime		

02-19-1952

CASING LEFT IN HOLE AFTER COMPLETION

Ran 191.19' (9 jts.) 8-5/8" OD Casing.

STATE OF KANSAS, COUNTY OF SEDGWICK) ss.

The undersigned certifies that to the best of his knowledge and belief, the above facts are true and correct.

C-G DRILLING CO.

By R.G. Cook
Partner

Subscribed and sworn to before me this 18th day of February, 1952.

My commission expires:

Marilyn Schmidt
Notary Public

November 21, 1955

PLUGGING
FILE SEC 18-10-20W
NO. 44 LINE 40