


15-163-00869-00-00

WELL PLUGGING RECORD

Give All Information Completely
Make Required Affidavit
Mail or Deliver Report to:
Conservation Division
State Corporation Commission
800 Bittling Building
Wichita, Kansas

Location Rooks County. Sec. 19 Twp. 10 Rge. 20 (E) W (W)
Location as "NE/CNW/SW" or footage from lines NW NW SE
Lease Owner C-G Drilling Co. & Oil Trading Associates, Inc.
Lease Name Gaede Well No. 1
Office Address 107 Rule Bldg., Wichita, Kansas
Character of Well (completed as Oil, Gas or Dry Hole) Dry Hole
Date well completed November 13 1955
Application for plugging filed November 13 1955
Application for plugging approved November 13 1955
Plugging commenced November 14 1955
Plugging completed November 14 1955
Reason for abandonment of well or producing formation Too low structurally

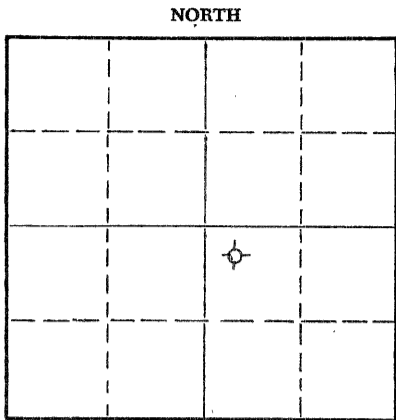

Locate well correctly on above Section Plat

If a producing well is abandoned, date of last production 19
Was permission obtained from the Conservation Division or its agents before plugging was commenced? Yes

Name of Conservation Agent who supervised plugging of this well Eldon Petty, Hays, Kansas
Producing formation _____ Depth to top _____ Bottom _____ Total Depth of Well 3762 Feet
Show depth and thickness of all water, oil and gas formations.

OIL, GAS OR WATER RECORDS

CASING RECORD

FORMATION	CONTENT	FROM	TO	SIZE	PUT IN	PULLED OUT
				8-5/8"	189'	none

Describe in detail the manner in which the well was plugged, indicating where the mud fluid was placed and the method or methods used in introducing it into the hole. If cement or other plugs were used, state the character of same and depth placed, from _____ feet to _____ feet for each plug set.

Filled hole with heavy mud to 184'. Set plug.
Put in 1/2 sack Hulls and 15 sacks of cement. Filled with heavy mud up to 40'. Set plug. Filled to top with 1/2 sack Hulls and 10 sacks of cement.

(If additional description is necessary, use BACK of this sheet)

Name of Plugging Contractor C-G Drilling Co.
Address 107 Rule Bldg., Wichita, Kansas

STATE OF Kansas, COUNTY OF Sedgwick, ss.
Jay H. Galloway (employee of owner) or (owner or operator) of the above-described well, being first duly sworn on oath, says: That I have knowledge of the facts, statements, and matters herein contained and the log of the above-described well as filed and that the same are true and correct. So help me God.

(Signature) Jay H. Galloway
107 Rule Building
(Address)

SUBSCRIBED AND SWORN TO before me this 17th day of November, 1955

My commission expires May 20, 1959

Vicky Jacobs
Vicky Jacobs
Notary Public.

PLUGGING
FILE SEC 19 T 10 R 20
BOOK PAGE 17 LINE 14

RECEIVED
NOV 18 1955
11-18-1955
CONSERVATION DIVISION
Wichita, K.

15-163-00869-00-00

CONTRACTOR'S WELL LOG

OPERATOR C-G DRILLING CO. & OIL TRADING ASSOCIATES, INC. WELL NAME GAEDE #1

LOCATION NW NW SE Sec. 19-10-20W

RIG #1

COUNTY ROOKS

STATE KANSAS

COMMENCEMENT DATE NOVEMBER 4, 1955

COMMENCEMENT DATE NOVEMBER 14, 1955

LOG OF WELL

Elevation 2104' rotary bushing.

All measurements from the top of rotary bushing.

FROM	TO	FORMATION	DEVIATION FROM VERTICAL	REMARKS
0	189	Shale		
189	700	Shale		
700	790	Sand		
790	910	Shale		
910	960	Sand		
960	1000	Sand-Shale		
1000	1120	Sandy Shale		
1120	1330	Sand		
1330	1608	Red Bed		
1608	1650	Anhydrite		
1650	1970	Shale-Shells		
1970	2350	Lime-Shale	0° - 2500'	
2350	2555	Lime-Shale		
2555	2780	Lime-Shale		
2780	2920	Lime-Shale	0° - 3000'	
2920	3120	Lime-Shale		
3120	3250	Lime-Shale		
3250	3350	Lime-Shale		
3350	3450	Lime-Shale	0° - 3500'	
3450	3535	Lime-Shale		
3535	3580	Lime		
3580	3720	Lime-Shale		
3720	3762	Lime-Shale		
	3762	TD		

CASING LEFT IN HOLE AFTER COMPLETION

189' of 8-5/8" OD Surface Casing.

STATE OF KANSAS, COUNTY OF SEDGWICK) ss.

The undersigned certifies that to the best of his knowledge and belief, the above facts are true and correct.

C-G DRILLING CO.

By Jay H. Galloway
Jay H. Galloway

Subscribed and sworn to before me this 17th day of November, 1955.

My commission expires:
May 20, 1958

Vicky Jacobs
Vicky Jacobs, notary public

RECEIVED
NOV 18 1955
CONSERVATION COMMISSION
CONSERVATION DIVISION
Wichita, Kansas

PLUGGING
WELL SEC 19 T 10 R 20W
BOOK PAGE 17 LINE 14