


WELL PLUGGING RECORD

Give All Information Completely
Make Required Affidavit
Mail or Deliver Report to:
Conservation Division
State Corporation Commission
211 No. Broadway
Wichita, Kansas

Rooks County. Sec. 19 Twp. 10S Rge. 20 (E) W (W)

Location as "NE/CNW $\frac{1}{4}$ SW $\frac{1}{4}$ " or footage from lines SE SE SE
Lease Owner Peel-Hardman Oil Operators
Lease Name Gaede Well No. 1
Office Address R.R. #3, Box 144B, Wichita 15, Kansas
Character of Well (completed as Oil, Gas or Dry Hole) Dry Hole
Date well completed September 16, 1957
Application for plugging filed September 16, 1957
Application for plugging approved September 16, 1957
Plugging commenced September 16, 1957
Plugging completed September 16, 1957
Reason for abandonment of well or producing formation Dry Hole

NORTH

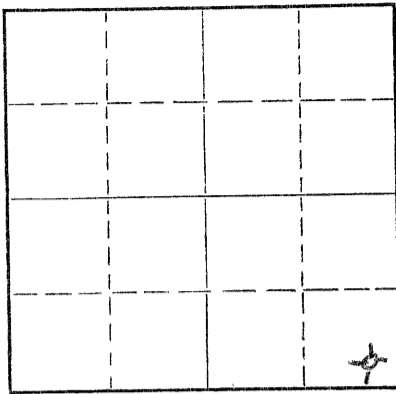

Locate well correctly on above
Section Plat

If a producing well is abandoned, date of last production _____ 19____
Was permission obtained from the Conservation Division or its agents before plugging was commenced? Yes

Name of Conservation Agent who supervised plugging of this well Eldon Petty
Producing formation _____ Depth to top _____ Bottom _____ Total Depth of Well 3798 Feet
Show depth and thickness of all water, oil and gas formations.

OIL, GAS OR WATER RECORDS

CASING RECORD

FORMATION	CONTENT	FROM	TO	SIZE	PUT IN	PULLED OUT
		0	188'	8 5/8"	188'	none

Describe in detail the manner in which the well was plugged, indicating where the mud fluid was placed and the method or methods used in introducing it into the hole. If cement or other plugs were used, state the character of same and depth placed, from _____ feet to _____ feet for each plug set.

From 3798' to 550' - heavy rotary mud
550' to 487' - plug and 20 sacks cement
487' to 180' - heavy rotary mud
180' to 117' - plug, 1/2 sack hulls, 20 sacks cement
117' to 40' - heavy rotary mud
40' to 6' - plug, 1/2 sack hulls, 10 sacks cement
6' to surface - cellar

10-09-1957

(If additional description is necessary, use BACK of this sheet)
Name of Plugging Contractor Peel Brothers, Inc.
Address P.O. Box 88, Hoisington, Kansas

STATE OF KANSAS, COUNTY OF BARTON, ss.
Peel Brothers, Inc. (employee of owner) or (~~owner or operator~~) of the above-described well, being first duly sworn on oath, says: That I have knowledge of the facts, statements, and matters herein contained and the log of the above-described well as filed and that the same are true and correct. So help me God. PEEL BROTHERS, INC.

(Signature) BY: Al H. Smith
P.O. Box 88, Hoisington, Kansas
(Address)

SUBSCRIBED AND SWORN TO before me this 24th day of September, 19 57

Ruth Brant

My commission expires April 27, 1960

Notary Public.

PLUGGING
FILE SEC 19 T 10 R 20W
BOOK PAGE 47 LINE 36

15-163-03086-00-00

DRILLERS' LOG

Company: Peel-Hardman Oil Operators

Farm Name: Gaede Well No. 1

Total Depth: 3798'

Comm: 9/9/57 Comp: 9/16/57
Contractor: Peel Brothers, Inc.

Casing: 8 5/8" @ 188' cem.

SE SE SE
Sec. 19, Twp. 10S, Rge. 20W,

County: Rooks,
Kansas

Elevation:

Production: Dry

Figures below indicate bottoms of formations:

Shale and sand	99
Shale	690
Shale and sand streaks	785
Sand	840
Shale and sand streaks	1130
Sand	1320
Shale and shells	1610
Anhydrite	1650
Red bed and shale	1800
Shale and red rock	2180
Lime and shale	3345
Lime	3685
Conglomerate	3798
Total Depth	3798

This is to certify that the above information is to the best of our knowledge,
true and correct.

PEEL BROTHERS, INC.

BY: Al H. Smith

SUBSCRIBED AND SWORN to before me this 24th day of September, 1957

My commission expires: April 27, 1960

Ruth Blank
Notary Public

PLUGGING
FILE SEC 19 T 10 R 20W
BOOK PAGE 47 LINE 36

STAY
OCT 9
10-09-1957
CONSERVATION
Wichita, Kansas