

STATE OF KANSAS
STATE CORPORATION COMMISSION

15-163-20970-00-00

WELL PLUGGING RECORD

Give All Information Completely
Make Required Affidavit
Mail or Deliver Report to
Conservation Division
State Corporation Comm.
245 North Water
Wichita, KS 67202

Rooks County, Sec. 19 Twp. 10s Rge. 20WE/
Location as "NE/CNW $\frac{1}{4}$ SW $\frac{1}{4}$ " or footage from lines

NE SW SE

Lease Owner Arrowhead Petroleum, Inc.

Lease Name Romine Well No. 1

Office Address Box 8287, Munger Station, Wichita, KS 672

Character of Well (Completed as Oil, Gas or Dry Hole)

Dry Hole

Date Well completed 9-18-79 19

Application for plugging filed 9-18-79 19

Application for plugging approved 9-18-79 19

Plugging commenced 9-18-79 19

Plugging completed 9-18-79 19

Reason for abandonment of well or producing formation

Dry Hole

If a producing well is abandoned, date of last production

N/A 19


Was permission obtained from the Conservation Division or its agents before plugging was commenced? yes

M. Schmidt

Name of Conservation Agent who supervised plugging of this well

Producing formation Depth to top Bottom Total Depth of Well 3715

Show depth and thickness of all water, oil and gas formations.

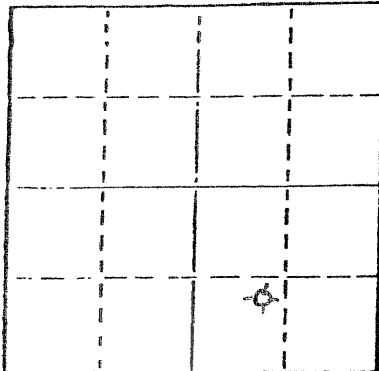

Locate well correctly on above Section Plot

OIL, GAS OR WATER RECORDS

CASING RECORD

FORMATION	CONTENT	FROM	TO	SIZE	PUT IN	PULLED OUT
Sand				8 5/8	210'	None

Describe in detail the manner in which the well was plugged, indicating where the mud fluid was placed and the method or methods used in introducing it into the hold. If cement or other plugs were used, state the character of same and depth placed, from _____ feet to _____ feet for each plug set.

60 sx 820'

30 sx 210'

10 sx 40'

3 sx RH

50 - 50 PAZ 6% gel

SEP 21 1979

09-21-1979
CONSERVATION DIVISION
Wichita, Kansas

(If additional description is necessary, use BACK of this sheet)

Name of Plugging Contractor Service Company

STATE OF Kansas COUNTY OF Sedgwick, ss.

Paul A. Seymour, Jr. (employee of owner) or (owner or operator of the above-described well, being first duly sworn on oath, says: That I have knowledge of the facts, statements, and matters herein contained and the log of the above-described well as filed and that the same are true and correct. So help me God.

(Signature)

Paul A. Seymour, Jr.

Box 8287, Munger Station, Wichita, KS

(Address)

SUBSCRIBED AND SWORN TO before me this 20th day of September, 19 79

Ruth M. Bassett

Ruth M. Bassett

Notary Public.

My commission expires May 30, 1983

BIG SPRINGS DRILLING, INC.

SUITE 29 • 400 NORTH WOODLAWN • (316) 681-1732

P.O. BOX 8287
MUNGER STATION
WICHITA, KANSAS 67208

September 20, 1979

DRILLERS LOG

Re: Romine No. 1
NE SW SE
Sec. 19- Twp 10s- Rq 20W
Rooks County, Kansas

15-163-20970-00-00

OPERATOR: Arrowhead Petroleum, Inc.
CONTRACTOR: Big Springs Drilling, Inc.
COMMENCED: 9-12-79
COMPLETED: 9-18-79

Surface Pipe: 210' of 8 5/8" w/150sx Common 2% gel 3% ccl

0	210	Sand and Clay
210	1595	Sand, Clay, Shale
1595	1645	Anhydrite
1645	2225	Shale and Shells
2225	3235	Shale
3235	3365	Lime and Shale
3365	3715	Lime
3715		RTD


RECEIVED
STATE CORPORATION COMMISSION
SEP 21 1979
09-21-1979
CONSERVATION DIVISION
Wichita, Kansas

We certify that the above and foregoing is a true and correct copy of the log on the # 1 Romine located in Rooks County, Kansas.

BIG SPRINGS DRILLING, INC.


Paul A. Seymour, Jr.

Subscribed and sworn to before me this 20th day of September, 1979.

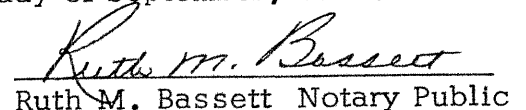
Ruth M. Bassett Notary Public

My Commission Expires:

May 30, 1983