

WELL PLUGGING RECORD

Give All Information Completely
Make Required Affidavit
Mail or Deliver Report to:
Conservation Division
State Corporation Commission
800 Bitting Building
Wichita, Kansas

(C. S/2 SW/4 SW/4) **Rooks** County. Sec. 19 Twp. 10S Rge. 20 (W)

Location as "NE/CNW $\frac{1}{4}$ SW $\frac{1}{4}$ " or footage from lines G. S/2 SW/4 SW/4

Lease Owner Heathman Drilling Co., Inc., et al

Lease Name GAEDE Well No. 1

Office Address 509 Orpheum Bldg., Wichita, Kansas

Character of Well (completed as Oil, Gas or Dry Hole) dry hole

Date well completed 3-28-1951

Application for plugging filed 3-28-1951

Application for plugging approved 3-28-1951


Plugging commenced 3-28-1951

Plugging completed 3-28-1951

Reason for abandonment of well or producing formation _____

If a producing well is abandoned, date of last production _____ 19__

Was permission obtained from the Conservation Division or its agents before plugging was commenced? YES

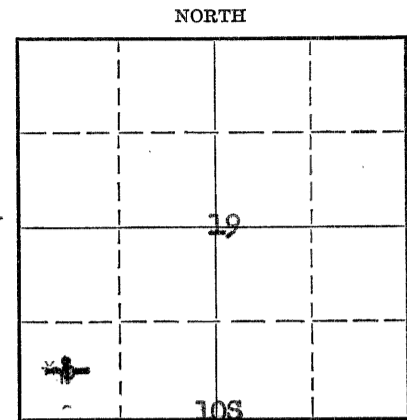

Locate well correctly on above Section Plat

Name of Conservation Agent who supervised plugging of this well Eldon Petty, Hays, Kansas

Producing formation none Depth to top _____ Bottom _____ Total Depth of Well 3850 Feet

Show depth and thickness of all water, oil and gas formations.

OIL, GAS OR WATER RECORDS

CASING RECORD

Formation	Content	From	To	Size	Put In	Pulled Out
<u>none</u>	---	---	---	<u>8-5/8" (new) 114' set @ 110' w/100 sacks cement and 1 sack Cal. Chloride.</u>		<u>none</u>

Describe in detail the manner in which the well was plugged, indicating where the mud fluid was placed and the method or methods used in introducing it into the hole. If cement or other plugs were used, state the character of same and depth placed, from _____ feet to _____ feet for each plug set.

Hole filled w/heavy mud and plug set @ 100' w/25 sacks cement. Pipe cut off 3' below level of ground.

RECEIVED
STATE CORPORATION COMMISSION
04-03-1951
APR - 3 1951
CONSERVATION DIVISION
Wichita, Kansas

(If additional description is necessary, use BACK of this sheet)

Correspondence regarding this well should be addressed to Heathman Drilling Co., Inc.

Address 509 Orpheum Bldg., Wichita, Kansas

STATE OF Kansas, COUNTY OF Sedgwick, ss.

Robert F. Walters (employee of owner ~~or owner or operator~~) of the above-described well, being first duly sworn on oath, says: That I have knowledge of the facts, statements, and matters herein contained and the log of the above-described well as filed and that the same are true and correct. So help me God. HEATHMAN DRILLING CO., INC.

(Signature) Robert F. Walters

509 Orpheum Bldg., Wichita, Kansas
(Address)

SUBSCRIBED AND SWORN to before me this 30th day of March, 1951

June 28, 1952

D. Maggiori Matt
Notary Public.

My commission expires _____

PLUGGING
FILE SEC 19 T 10 R 20W
BOOK PAGE 70 LINE 33

15-163-03335-00-00

GAEDE WELL # 1

Location: G. S/2 SW/4 SW/4 Sec.19-108-20W Date Spudded: 3-18-51
 Rooks County, Kansas Date Rotary Completion: 3-28-51

Operator: Heathman Drilling Co., Inc. Total Depth: 3850'

Contractor: Heathman Drilling Co., Inc. Elevation: 2122 Gr
 2125 DF
 2127 KB

Surface Casing: 5 jts. (new) 8-5/8" 11 1/2' set
 at 110' w/100 sacks and 1 Cal.
 Chloride.

Oil String: Non run - Plugged and abandoned
 3-28-51

T O P S (KB)

Anhydrite	1596 (+ 535)
Topeka	3169 (-1042)
Heebner	3381 (-1254)
Lansing-Kansas City	3421 (-1294)
Base of Kansas City	3646 (-1519)
Chert Conglomerate	3686 (-1559)
Arbuckle	3792 (-1665)
Rotary Total Depth	3850' (-1733)

L O G

(Figures indicate bottom of formation)

Sand and shale	0 to 112
Cement and shale	350
Shale and sand	900
Shale and sand	1150
Sand	1320
Sand and shale	1596
Anhydrite	1640
Shale	1655
Shale and shells	1935
Shale and shells	2205
Shale and lime	3764
Shale	3161
Lime and shale	3496
Lime	3627
Lime and shale	3715
Lime and chert	3761
Conglomerate	3850
Total Depth	3850'

The undersigned, Heathman Drilling Co., Inc., hereby certifies that the above log is a true and correct log of the formations encountered in drilling the above noted well as reflected by the Daily Drilling Reports.

HEATHMAN DRILLING CO., INC.

By:

Robert F. Walker

Subscribed and sworn to before me this 30th day of March 1951

Marjorie M. Oet
Notary Public

My commission expires: June 28, 1952.

RECEIVED
 STATE CORPORATION
 APR 3 1951
 CONSERVATION DIVISION
 WICHITA, KANSAS
 04-03-1951

PLUGGING
 WILE SEC 19 T 10 R 20 W
 SMOCK PAGE 70 LINE 33