

TYPE

AFFIDAVIT OF COMPLETION FORM

ACO-1 WELL HISTORY

Compt. _____

SIDE ONE

Two (2) copies of this form shall be filed with the Kansas Corporation Commission, 200 Colorado Derby Building, Wichita, Kansas 67202, within thirty (30) days after the completion of a well, regardless of how the well was completed.

F Attach separate letter of request if the information is to be held confidential. If confidential, only file one copy. Information on Side One will be of public record and Side Two will then be held confidential.

Applications must be made on dual completion, commingling, salt water disposal, injection and temporarily abandoned wells.

C Attach one copy only wireline logs (i.e. electrical log, sonic log, gamma ray neutron log, etc.). (Rules 82-2-105 & 82-2-125) KCC# (316) 263-3238. No log run.

LICENSE # 5804 EXPIRATION DATE June 30, 1983

OPERATOR Dreilling Ltd. of Colorado API NO. 15-163-21-887-00-00

ADDRESS 410 - 17th St., Suite 1140 COUNTY Rooks

Denver, Colorado 80202 FIELD _____

** CONTACT PERSON Floyd H. Hoffman PROD. FORMATION _____

PHONE (303) 623-6144

PURCHASER _____ LEASE Kuehnl "B"

ADDRESS _____ WELL NO. 1

WELL LOCATION _____


DRILLING C and R Drilling Co. 430 Ft. from West Line and

CONTRACTOR ADDRESS 410 - 17th St., Suite 1140 1760 Ft. from North Line of

Denver, Colorado 80202 the NE (Qtr.) SEC 32 TWP 9S RGE 20 (W).

PLUGGING Halliburton WELL PLAT (Office Use Only)

CONTRACTOR ADDRESS Hays, Kansas

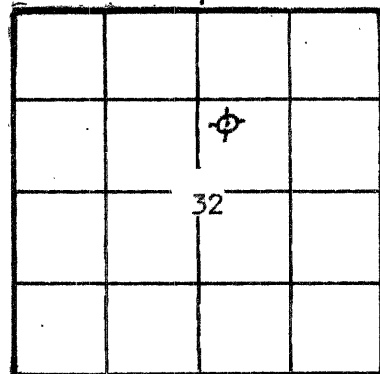

KCC [checked] KGS [checked]

SWD/REP _____ PLG. _____

TOTAL DEPTH 2350 PBTD _____

SPUD DATE 11-30-82 DATE COMPLETED 12-2-82

ELEV: GR 2239 DF _____ KB 2244

DRILLED WITH (CABLE) (ROTARY) (AIR) TOOLS.

DOCKET NO. OF DISPOSAL OR REPRESSURING WELL BEING USED TO DISPOSE OF WATER FROM THIS LEASE _____

Amount of surface pipe set and cemented 253 DV Tool Used? No

THIS AFFIDAVIT APPLIES TO: (Circle ONE) - Oil, Gas, Shut-in Gas, Dry, Disposal, Injection, Temporarily Abandoned, OWWO. Other _____

ALL REQUIREMENTS OF THE STATUTES, RULES AND REGULATIONS PROMULGATED TO REGULATE THE OIL AND GAS INDUSTRY HAVE BEEN FULLY COMPLIED WITH.

A F F I D A V I T

Leslie Olson, being of lawful age, hereby certifies that:

I am the Affiant, and I am familiar with the contents of the foregoing Affidavit. The statements and allegations contained therein are true and correct.

Signature of Leslie Olson (Name)

SUBSCRIBED AND SWORN TO BEFORE ME this 7th day of December, 19 82.

Signature of Lorraine C. Murphy (NOTARY PUBLIC)

MY COMMISSION EXPIRES: 9-2-83

RECEIVED

STATE CORPORATION COMMISSION

** The person who can be reached by phone regarding any questions concerning this information.

DEC 10 1982

CONSERVATION DIVISION Wichita, Kansas

SIDE TWO

ACO-1 WELL HISTORY

OPERATOR Dreiling Ltd. of Colorado LEASE Kuehnl "B" SEC. 32 TWP 9S RGE 20W

FILL IN WELL INFORMATION AS REQUIRED:

WELL NO. 1

Show all important zones of porosity and contents thereof; cored intervals, and all drill-stem tests, including depth interval tested, cushion used, time tool open, flowing and shut-in pressures, and recoveries.

SHOW GEOLOGICAL MARKERS, LOGS RUN, OR OTHER DESCRIPTIVE INFORMATION.

FORMATION DESCRIPTION, CONTENTS, ETC.	TOP	BOTTOM	NAME	DEPTH
<input checked="" type="checkbox"/> Check if no Drill Stem Tests Run. NO LOG				
ANHYDRITE	1778'	1809'	ANHYDRITE	1778

If additional space is needed use Page 2, Side 2

Report of all strings set— surface, intermediate, production, etc. CASING RECORD (New) or (Used)

Purpose of string	Size hole drilled	Size casing set (in O.D.)	Weight lbs/ft.	Setting depth	Type cement	Sacks	Type and percent additives
Surface	12-1/4	8-5/8	24#	253	Common	180	2% gel, 3% cc

LINER RECORD			PERFORATION RECORD		
Top, ft.	Bottom, ft.	Sacks cement	Shots per ft.	Size & type	Depth interval

TUBING RECORD		
Size	Setting depth	Packer set at

ACID, FRACTURE, SHOT, CEMENT SQUEEZE RECORD

Amount and kind of material used	Depth interval treated

Date of first production	Producing method (flowing, pumping, gas lift, etc.)	Gravity

Estimated Production -I.P.	Oil	Gas	Water	Gas-oil ratio
	bbls.	MCF	%	bbls.

Disposition of gas (vented, used on lease or sold) Perforations