

KCC OIL/GAS REGULATORY OFFICES

15-133-24996-00-00 RECEIVED
KANSAS CORPORATION COMMISSION

DEC 17 2007

CONSERVATION DIVISION
WICHITA, KS

Date 12-Dec-07

XXXXXX New Situation
XXXXXX Response to Request
XXXXXX Follow-up

Qtr, Qtr SW SE Sec. 28 Twp. 28S Rge. R19E

Operator State Of Kansas License # _____

Address _____

Address _____ Lease/Well # Hall, Milford

Phone # _____ County Neosho

Lease Inspection _____ Complaint _____ Field Report XXXXXX

Reason For Investigation: Request from Amy Banks, KCC, Wichita, KS

Problem Determine the location of well no. 24

Persons Contacted Amy Banks

Findings 11-07-07: An abandoned well was located and GPS'd as HAL01. The GPS footages for HAL01 are very similar to the footages for Hall #24 which is in RBDMS (API# 15-133-24996-00-00).

Section 27 T28S R19E, Neosho County was also searched but no well was found.

Photos Taken Yes - 1

Actions/Recommendations The correct location for well #24 is Section 28 T28S R19E, Neosho County. The correct API# is 15-133-24996-00-00. This report along with a picture and the gps map will be submitted to Amy Banks, KCC, Wichita.

By: Alan M. Dunning
Alan M. Dunning, PIRT

Retain 1 copy District Office
Send 1 copy Conservation Division

Hall, Milford Lease: NO CO S28 - T28S - R19E

Operator: State of Kansas


Compiled: 11-7-2007

Hall, Milford Lease NO CO

95° 17' 24.639" W

37° 36' 3.652" N

95° 22' 19.740" W
37° 35' 57.820" N

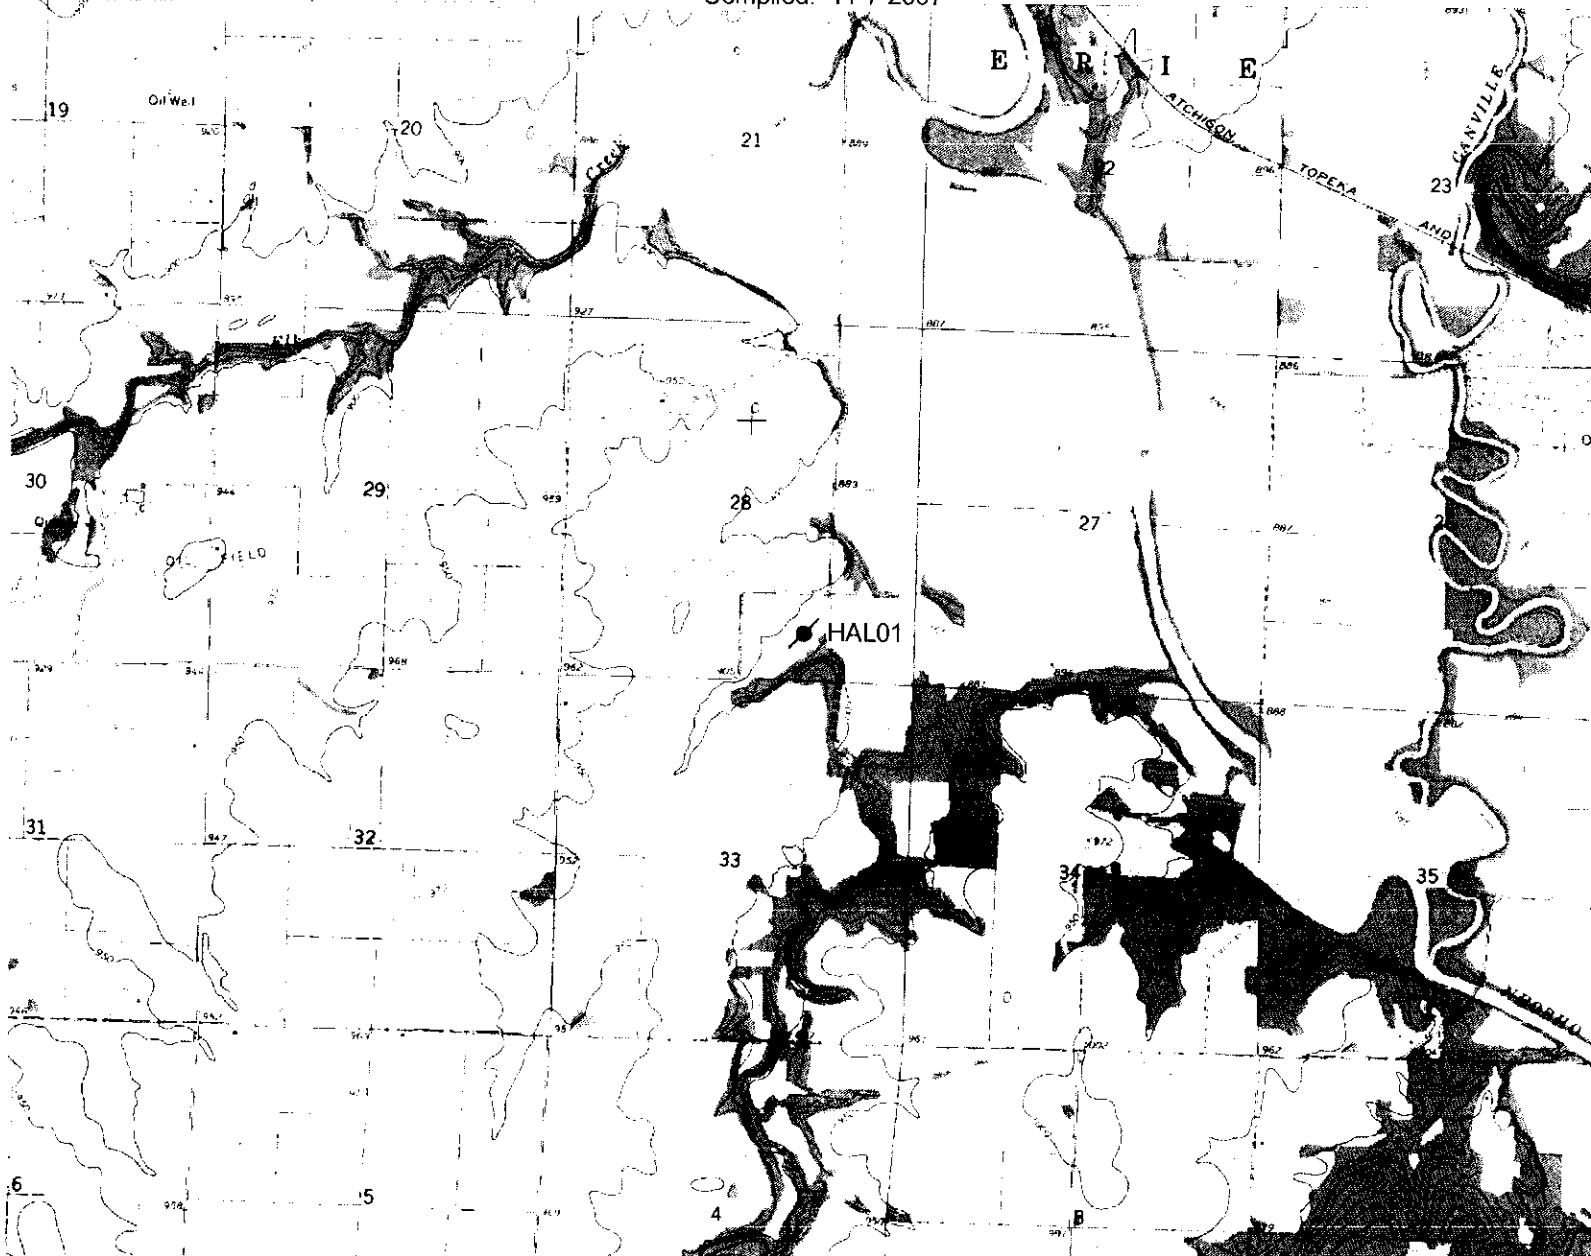


37° 32' 55.198" N
95° 22' 13.946" W

37° 33' 1.020" N
95° 17' 19.045" W

1927 North American Datum; UTM grid zone 15
Generated by BigTopo7 (www.igage.com)
Map compiled from USGS Quads: Shaw, KS


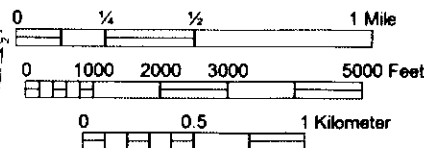

KANSAS CORPORATION COMMISSION
CONSERVATION DIVISION
WICHITA, KS

DEC 17 2007

513324996-000

BigTopo Map

COUNTY	LEASE	SES.PT	ATTRIBUT	DESCRIPTION	Q3	Q2	Q1	SEC	TWP	RGE	FEL	FSL	OPERATOR
--------	-------	--------	----------	-------------	----	----	----	-----	-----	-----	-----	-----	----------

NO

TOTAL WELLS IN PROJECT 1

Hall, Milford	HAL01		OIL-AB-2	2CITPJ-BSE-BURIED	NE	SW	SE	28	28	19	-1723	753	State of Kansas
---------------	-------	--	----------	-------------------	----	----	----	----	----	----	-------	-----	-----------------

RECEIVED
 KANSAS CORPORATION COMMISSIONERS
 DEC 17 2007
 CONSERVATION DIVISION
 WICHITA, KS

K-133-24996-00-00



Picture 1 of 1

Name Of Lease Site: Hall, Milford

Operator: State Of Kansas

Location: NE SW SE

Legal: Section 28 T28S R19E

County: Neosho

General Direction Faced: North

Weather Conditions: Clear

Additional: This picture is a well that was GPS'd as HAL01. It's footages are very similar to well #24 which is in RBDMS.

Date / Time: 11-7-07 p.m.

RECEIVED
KANSAS CORPORATION COMMISSION

DEC 17 2007

CONSERVATION DIVISION
WICHITA, KS