


STATE OF KANSAS
STATE CORPORATION COMMISSION

Give All Information Completely
Make Required Affidavit
Mail or Deliver Report to:
Conservation Division
State Corporation Commission
800 Biting Building
Wichita, Kansas

15-103-03269-00-00
WELL PLUGGING RECORD

NORTH

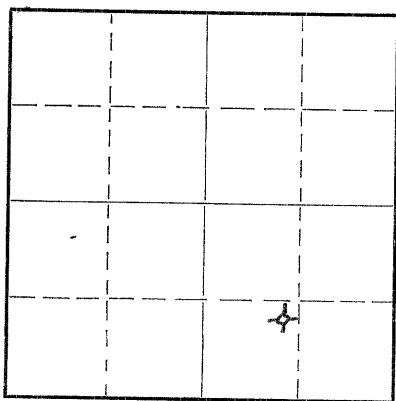

Locate well correctly on above Section Plat

Rooks County. Sec. 35 Twp. 10s Rge. (E) 20 (W)
Location as "NE/CNW $\frac{1}{4}$ SW $\frac{1}{4}$ " or footage from lines NE $\frac{1}{4}$ -SW $\frac{1}{4}$ -SE $\frac{1}{4}$
Lease Owner Champlin Refining Company
Lease Name R. E. Teall Well No. 1
Office Address Dr. #552, Enid, Oklahoma.
Character of Well (completed as Oil, Gas or Dry Hole) Dry Hole
Date well completed December 2, 19 51
Application for plugging filed December 1, 19 51
Application for plugging approved December 1, (Verbal) 19 51
Plugging commenced December 2, 19 51
Plugging completed December 2, 19 51
Reason for abandonment of well or producing formation

If a producing well is abandoned, date of last production 19
Was permission obtained from the Conservation Division or its agents before plugging was commenced? Yes

Name of Conservation Agent who supervised plugging of this well Eldon Petty, Hays, Kansas.
Producing formation Depth to top Bottom Total Depth of Well 3920' Feet
Show depth and thickness of all water, oil and gas formations.

OIL, GAS OR WATER RECORDS

CASING RECORD

Formation	Content	From	To	Size	Put In	Pulled Out
				8 5/8" OD	151'	None

Describe in detail the manner in which the well was plugged, indicating where the mud fluid was placed and the method or methods used in introducing it into the hole. If cement or other plugs were used, state the character of same and depth placed, from feet to feet for each plug set.

Filled hole with heavy mud from 3920' TD to 145', Pumped plug to 145' and set plug using 15 sacks of cement then filled with heavy mud from top of cement to 40' and set plug and dumped 1/2 sack of cotton seed hulls on top and then set cement plug to bottom of cellar using 10 sacks of cement.

Used Globe Cementing Company to run plugs and pump in cement.

(If additional description is necessary, use BACK of this sheet)

Correspondence regarding this well should be addressed to Champlin Refining Company
Address P. O. Dr. #552, Enid, Oklahoma.

STATE OF Kansas, COUNTY OF Barton, ss.
S. P. Hall (employee of owner) or (owner or operator) of the above-described well,

being first duly sworn on oath, says: That I have knowledge of the facts, statements, and matters herein contained and the log of the above-described well as filed and that the same are true and correct. So help me God.

(Signature) S. P. Hall
P. O. Box 167
Ellinwood, Kansas.
(Address)

SUBSCRIBED AND SWORN to before me this 6th day of December, 19 51

My commission expires September 10, 1955

W. Kenneth Stover
Notary Public.

15-163-03269-00-00

R.E. TEALL #1

990' from the South line
(FSL), and 1600' from the
East line (FEL) of the
Southeast Quarter (SE/4)
of Sec. 35-10S-20W.

Formation log

0'	- 60'	Sand and surface clay
60'	- 151'	Sand and shale
151'	- 535'	Shale
535'	- 1065'	Shale and sand
1065'	- 1450'	Shale, sand and shells
1450'	- 1580'	Shells and shale
1580'	- 1625'	Anhydrite
1625'	- 1895'	Redbed and shells
1895'	- 2406'	Shale and shells
2406'	- 3320'	Lime and shale
3320'	- 3673'	Lime
3673'	- 3808'	Lime and conglomerate
3808'	- 3865'	Conglomerate
3865'	- 3899'	Conglomerate and lime
3899'	- 3920'	Conglomerate, lime and arbuckle
3920'	- Total	Depth

35-10-20W
12-8-1951