

15-163-03270-00-00
WELL PLUGGING RECORD

STATE OF KANSAS
STATE CORPORATION COMMISSION

Give All Information Completely
Make-Required Affidavit
Mail or Deliver Report to:
Conservation Division
State Corporation Commission
800 Bittling Building
Wichita, Kansas

Handwritten initials

Rooks County. Sec. 35 Twp. 10 Rge. 20 (B) (W)

Location as "NE/CNW $\frac{1}{4}$ SW $\frac{1}{4}$ " or footage from lines C-SH $\frac{1}{4}$ NW $\frac{1}{4}$ NE $\frac{1}{4}$

Lease Owner Midstates Oil Corporation

Lease Name Raymond Teall "B" Well No. 2

Office Address 518 National Bank of Tulsa Building Tulsa, Oklahoma

Character of Well (completed as Oil, Gas or Dry Hole) Dry Hole

Date well completed December 29 19 51

Application for plugging filed December 29 (Verbal) 19 51

Application for plugging approved December 29 (Verbal) 19 51


Plugging commenced December 30 19 51

Plugging completed December 30 19 51

Reason for abandonment of well or producing formation Dry Hole

If a producing well is abandoned, date of last production _____ 19 _____

Was permission obtained from the Conservation Division or its agents before plugging was commenced? Yes

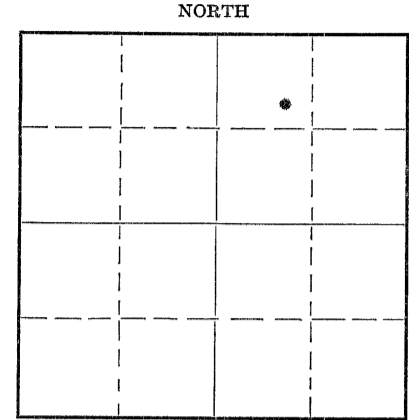

Locate well correctly on above Section Plat

Name of Conservation Agent who supervised plugging of this well Mr. Elden Petty

Producing formation _____ Depth to top _____ Bottom _____ Total Depth of Well 3848' Feet

Show depth and thickness of all water, oil and gas formations.

OIL, GAS OR WATER RECORDS

CASING RECORD

Formation	Content	From	To	Size	Put In	Pulled Out
				<u>8-5/8"</u>	<u>160'</u>	<u>None</u>

Describe in detail the manner in which the well was plugged, indicating where the mud fluid was placed and the method or methods used in introducing it into the hole. If cement or other plugs were used, state the character of same and depth placed, from _____ feet to _____ feet for each plug set.

Filled hole with rotary mud from 3848' to 155'. Set a Halliburton at 155'. Dumped 50# Hulls on plug and followed with 15 sacks of cement. Filled with rotary mud to 40'. Set Halliburton plug at 40'. Dumped 50# Hulls on top of plug and followed with 10 sacks of cement which filled casing to top.

Handwritten: 01-17-1952

(If additional description is necessary, use BACK of this sheet)

Correspondence regarding this well should be addressed to Midstates Oil Corporation

Address 518 National Bank of Tulsa Building Tulsa, Oklahoma

STATE OF Kansas COUNTY OF Rooks, ss. R.H. Fulton - Petroleum Engineer (employee of owner) or (~~owner or operator~~) of the above-described well,

being first duly sworn on oath, says: That I have knowledge of the facts, statements, and matters herein contained and the log of the above-described well as filed and that the same are true and correct. So help me God.

(Signature) R.H. Fulton


P.O. Box 151 Hays, Kansas
(Address)

SUBSCRIBED AND SWORN TO before me this 31 day of December, 19 51

Nace M. Stagwell
Notary Public.

My commission expires _____

My Commission Expires June 1, 1952

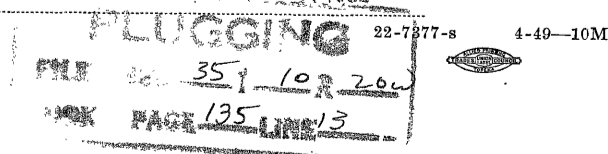

15-163-03270-00-200

CORPORATION COMMISSION OF
KANSAS

WELL RECORD

PRODUCER: Midstates Oil Corp., 518 Nat'l Bank of Tulsa Bldg., Tulsa, Oklahoma

FARM NAME: Raymond E. Teall "B" WELL NUMBER: Two (2)

WELL LOCATION: C SE/4 NW/4 NE/4 Sec. 35-10S-20W

DRILLING BEGAN: December 16, 1951 DRILLING COMPLETED: December 29, 1951

PRODUCING FORMATION: None - Plugged and Abandoned December 30, 1951

CASING RECORD

<u>Size Casing</u>	<u>Where Set</u>	<u>Number of Sacks of Cement</u>
8-5/8"	160'	125 sacks

<u>Formation</u>	<u>Top</u>	<u>Bottom</u>
Surface Clay	0	35
Sand	35	45
Shells	45	80
Sand	80	95
Sand & Shells	95	162
Shale	162	675
Chalky Shale	675	745
Sandy Shale	745	850
Sand	850	890
Shale	890	990
Shale & Shells	990	1150
Sand	1150	1320
Shale & Shells	1320	1610
Anhydrite	1610	1655
Shale & Shells	1655	2305
Lime	2305	2625
Shale & Lime	2625	2720
Lime & Shale	2720	2835
Shale & Lime	2835	2955
Lime & Shale	2955	3145
Lime	3145	3780
Shale & Lime	3780	3830
Lime	3830	3848
Total Depth		3848

Signed: W. J. Barclay

DATE: January 3, 1952

LOGGING
 FILE REC 35 10 S 20 W
 PAGE 135 LINE 13

01-17-1952