


STATE OF KANSAS
STATE CORPORATION COMMISSION

Give All Information Completely
Make Required Affidavit
Mail or Deliver Report to:
Conservation Division
State Corporation Commission
800 Bitting Building
Wichita, Kansas

WELL PLUGGING RECORD

NORTH

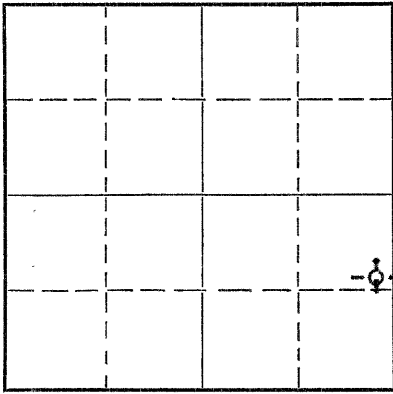

Locate well correctly on above
Section Plat

Rooks County. Sec. 26 Twp. 10 Rge. 20 (E) W (W)
Location as "NE/CNW 1/4 SW 1/4" or footage from lines SE NE SE
Lease Owner Nadel and Gussman
Lease Name Sutor A Well No. 2
Office Address 703 Union National Bank Building
Character of Well (completed as Oil, Gas or Dry Hole) Dry
Date well completed 12-30-50
Application for plugging filed 12-30-50
Application for plugging approved 12-30-50
Plugging commenced 12-30-50
Plugging completed 12-30-50
Reason for abandonment of well or producing formation Dry

If a producing well is abandoned, date of last production 19
Was permission obtained from the Conservation Division or its agents before plugging was commenced? Yes

Name of Conservation Agent who supervised plugging of this well Petty
Producing formation Depth to top Bottom Total Depth of Well 3801 Feet
Show depth and thickness of all water, oil and gas formations.

OIL, GAS OR WATER RECORDS

CASING RECORD

Formation	Content	From	To	Size	Put In	Pulled Out
				8-5/8	168	None

Describe in detail the manner in which the well was plugged, indicating where the mud fluid was placed and the method or methods used in introducing it into the hole. If cement or other plugs were used, state the character of same and depth placed, from feet to feet for each plug set.

Filled hole heavy mud 3801 to 165' - set plug at 165' with 15 sacks cement on top -
Filled with mud to 40' - set plug and 10 sacks of cement at top of hole

RECEIVED
STATE CORPORATION COMMISSION
01-12-1951
JAN 12 1951
CONSERVATION DIVISION
Wichita, Kansas

(If additional description is necessary, use BACK of this sheet)
Correspondence regarding this well should be addressed to Nadel and Gussman
Address P. O. Box 309, Tulsa, Oklahoma

STATE OF KANSAS, COUNTY OF SEDGWICK, ss.
L. C. Hay (employee of owner) or (owner or operator) of the above-described well,
being first duly sworn on oath, says: That I have knowledge of the facts, statements, and matters herein contained and the log of the above-described well as filed and that the same are true and correct. So help me God.

(Signature) L. C. Hay
Wichita, Kansas (Address)

SUBSCRIBED AND SWORN to before me this 30th day of December 1950
Notary Public

My commission expires Nov. 3, 1952

PLUGGING
FILE SEC 26 T 10 R 20 W
BOOK PAGE 54 LINE 6

15-163-03490-00-00

WELL LOG

Company- Hadel and Gussman

Sutor A-2

SE NE SE 26-10S-20W
Rooks County, Kansas

Comm: 12-15-50

Comp: 12-30-50

Casing: 8-5/8" 168' w/85 sax

Surface	177
Shale	300
Shale, sand, shells	1095
Sand	1300
Shale and shells	1525
Anhydrite	1640
Shale and Red Bed	1725
Shale, shells	2220
Broken lime	2330
Shale, lime	2420
Broken lime	2545
Florence Flint	2555
Shale, lime	2655
Shale and shells	2820
Shale and lime	3005
Shale and shells	3100
Shale and lime	3215
Shale and shells	3324
Lime and shale	3470
Lime	3697
Shale and lime	3734
Conglomerate	3801

Geological Tops

Harbner	3414
Toronto	3435
Lansing	3460
Conglomerate	3710
T.D.	3801

STATE OF KANSAS

COUNTY OF SEDGWICK

} ss

L. C. Hay, of lawful age, deposes and states that the above formations and depths are true and correct as taken from the daily drilling log covering the Sutor A-2 Well in the SE NE SE 26-10S-20W, Rooks County, Kansas.

L. C. Hay

Subscribed and sworn to before me this 30th day of December, 1950.

W. B. Bess

Notary Public

My commission expires Nov. 3, 1952

PLUGGING
 FILE SEC 26 10 R 20W
 PAGE 54 LINE 6