


Give All Information Completely
Make Required Affidavit
Mail or Deliver Report to:
Conservation Division
State Corporation Commission
211 No. Broadway
Wichita, Kansas

15-163-03156-00-00

WELL PLUGGING RECORD

NORTH

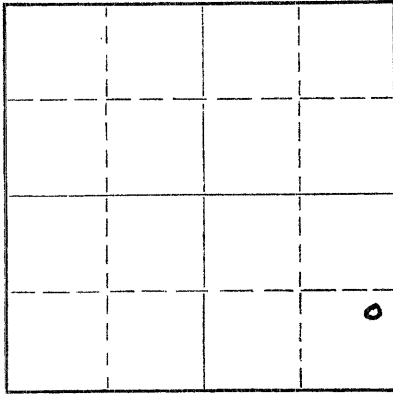

Locate well correctly on above Section Plat

Rooks County, Sec. 26 Twp. 10S Rge. (E) 20 (W)
Location as "NE/CNW/SW" or footage from lines NE 1/4 - SE 1/4 - SE 1/4
Lease Owner Champlin Refining Company
Lease Name Belisle Well No. 1
Office Address P.O. Dr. #552, Enid, Oklahoma
Character of Well (completed as Oil, Gas or Dry Hole) Oil
Date well completed December 2, 1950
Application for plugging filed July 9, 1956
Application for plugging approved July 10, (verbal) 1956
Plugging commenced July 11, 1956
Plugging completed July 13, 1956
Reason for abandonment of well or producing formation Non commercial
If a producing well is abandoned, date of last production July 7, 1956
Was permission obtained from the Conservation Division or its agents before plugging was commenced? Yes

Name of Conservation Agent who supervised plugging of this well Mr. Eldon Petty
Producing formation _____ Depth to top _____ Bottom _____ Total Depth of Well 3760 Feet
Show depth and thickness of all water, oil and gas formations.

OIL, GAS OR WATER RECORDS

CASING RECORD

FORMATION	CONTENT	FROM	TO	SIZE	PUT IN	PULLED OUT
				8-5/8" OD	251'	None
				5 1/2" OD	3755'	2511'

Describe in detail the manner in which the well was plugged, indicating where the mud fluid was placed and the method or methods used in introducing it into the hole. If cement or other plugs were used, state the character of same and depth placed, from _____ feet to _____ feet for each plug set.

Filled hole with crushed rock from 3760' TD to 3745' and used dump bailer to dump 5 sacks of cement; then filled hole with heavy mud to 245' and set a rock bridge and 20 sacks of cement; then filled hole with mud to 35' and set cement plug in top, using 10 sacks of cement, filling hole to bottom of cellar.

(If additional description is necessary, use BACK of this sheet)

Name of Plugging Contractor Miller Casing Pulling Company
Address Great Bend, Kansas

STATE OF Kansas, COUNTY OF Barton, ss.
J.W. Meyers (employee of owner) or (owner or operator) of the above-described well, being first duly sworn on oath, says: That I have knowledge of the facts, statements, and matters herein contained and the log of the above-described well as filed and that the same are true and correct. So help me God.
(Signature) [Signature]
P.O. Box 167, Ellinwood, Kansas (Address)

SUBSCRIBED AND SWORN TO before me this 17 th day of July 19 56

My commission expires Sept. 10, 1959

[Signature]
Notary Public.

PLUGGING
FILE SEC. 26 T. 10 R. 20W
BOOK PAGE 78 LINE 28

07-18-1956

15-163-03156-00-00

TO KANSAS CORPORATION COMMISSION
Conservation Division
800 Bitting Building
Wichita, Kansas

County Rooks SEC. 26 TWP. 10S RGE. 20W

COMPANY OPERATING Champlin Refining Company

OFFICE ADDRESS P.O. Dr. #552, Enid, Oklahoma

FARM NAME Belisle WELL NO. 1

WELL LOCATED Three Hundred Thirty Feet from the East

Line and Nine Hundred Ninety Feet from the South Line.

CHARACTER OF WELL Oil

			o

DRILLING COMMENCED November 9, 1950 DRILLING COMPLETED November 24, 1950

SIZE	WEIGHT	THDS	MAKE	FT.	AMOUNT PULLED	CEMENT
8 5/8"	24#	8rd.	Natl. Tube	251'		175 sx.
5 1/2"	14#	8rd.	Natl.	3773.77'		200 sx.

FORMATION RECORD

TOPS	BOTTOM		TOPS	BOTTOM
0	- 274	Sand & Shale		
247	- 810	Shale		
810	- 1300	Shale & Sand		
1300	- 1585	Shale & Shells		
1585	- 1610	Shale		
1610	- 1655	Anhydrite		
1655	- 1762	Shale		
1762	- 2200	Shale & Shells		
2200	- 2285	Lime & Shale		
2285	- 2535	Lime & Shale		
2535	- 2645	Broken Lime & Shale		
2645	- 2835	Shale & Lime		
2835	- 2918	Shale & Lime Shells		
2918	- 2955	Shale & Shells		
2955	- 3075	Lime & Shale		
3075	- 3255	Shale & Lime		
3255	- 3318	Broken Lime & Shale		
3318	- 3660	Lime		
3660	- 3715	Lime & Conglomerate		
3715	- 3742	Lime		
3742	- 3751	Shale		
3751	- 3757	Shale & Arbuckle		
3757	- 3760	Shale & Arbuckle		
	3760	T.D.		

07-10-1956

Subscribed and sworn to before me
this 9th day of July, 1956

My commission expires Sept. 10, 1959

[Signature]
Superintendent

[Signature]
Notary Public

PLUGGING
FILE SEC 26 T 10 R 20W
BOOK PAGE 78 LINE 28