


STATE OF KANSAS
STATE CORPORATION COMMISSION

15-163-03404-00-00

WELL PLUGGING RECORD

Give All Information Completely
Make Required Affidavit
Mail or Deliver Report to:
Conservation Division
State Corporation Commission
800 Bitting Building
Wichita, Kansas

NORTH

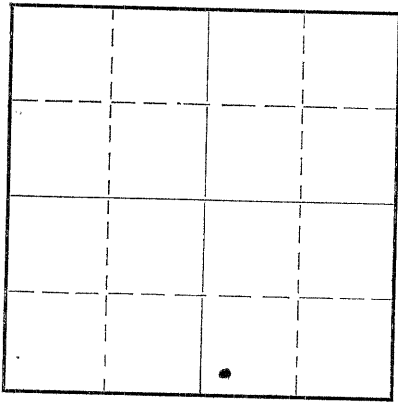

Locate well correctly on above
Section Plat

Rooks County. Sec. 26 Twp. 10s Rge. (E) 20 (W)
Location as "NE/CNW $\frac{1}{4}$ SW $\frac{1}{4}$ " or footage from lines SW $\frac{1}{4}$ -SW $\frac{1}{4}$ --SE $\frac{1}{4}$
Lease Owner Champlin Refining Company
Lease Name Belisle Well No. 2
Office Address P. O. Dr. #552, Enid, Oklahoma.
Character of Well (completed as Oil, Gas or Dry Hole) Dry hole
Date well completed October 18, 19 51
Application for plugging filed October 17, (Verbal) 19 51
Application for plugging approved October 17, (Verbal) 19 51
Plugging commenced October 18, 19 51
Plugging completed October 18, 19 51
Reason for abandonment of well or producing formation _____

If a producing well is abandoned, date of last production _____ 19_____
Was permission obtained from the Conservation Division or its agents before plugging was commenced? Yes

Name of Conservation Agent who supervised plugging of this well Eldon Petty, Hays, Kansas.
Producing formation _____ Depth to top _____ Bottom _____ Total Depth of Well 3864' Feet
Show depth and thickness of all water, oil and gas formations.

OIL, GAS OR WATER RECORDS

CASING RECORD

Formation	Content	From	To	Size	Put In	Pulled Out
				9"OD	132'	None

Describe in detail the manner in which the well was plugged, indicating where the mud fluid was placed and the method or methods used in introducing it into the hole. If cement or other plugs were used, state the character of same and depth placed, from _____ feet to _____ feet for each plug set.

Filled hole with heavy mud from 3864' total depth to 120' and set bridging plug and pumped in 15 sacks of cement then filled hole with mud from top of cement to 30' and dumped in $\frac{1}{2}$ sack of hulls and set cement plug in top using 10 sacks of cement. Used Globe Oil Well Cementing Co. to plug well.

RECEIVED
10-24-1951
OCT 24 1951
CONSERVATION DIVISION
WICHITA, KANSAS

(If additional description is necessary, use BACK of this sheet)

Correspondence regarding this well should be addressed to Champlin Refining Company
Address P. O. Dr. #552,
Enid, Oklahoma.


STATE OF Kansas, COUNTY OF Barton, ss.

S. P. Hall (employee of owner) or (owner or operator) of the above-described well, being first duly sworn on oath, says: That I have knowledge of the facts, statements, and matters herein contained and the log of the above-described well as filed and that the same are true and correct. So help me God.

(Signature) S. P. Hall
Box 167, Ellinwood, Kansas. (Address)

SUBSCRIBED AND SWORN TO before me this 23rd. day of October, 19 51

My commission expires September 10, 1955
N. Kenneth Sturin Notary Public.

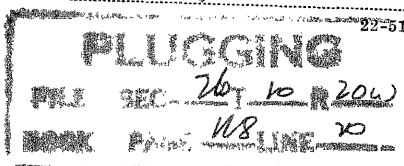

22-5133-s 9-48-10M

CHAMPLIN REFINING COMPANY

Belisle #2

330' from the South Line
(FSL) and 2285' from the
East Line (FEL) of the
Southeast quarter (SE/4)
of Section Twenty-six (26)
Township Ten South (10S),
Range Twenty West (20W),
Rooks County, Kansas

FORMATION LOG

0'	-132'	Sand & Shale.
132'	-1115'	Clay, Sand & Shale.
1115'	-1465'	Sand, Shale & Red Bed.
1465'	-1665'	Red Bed, Shale & Anhydrite.
1665'	-1905'	Anhydrite, Shale & Shells.
1905'	-2110'	Shale & Anhydrite.
2110'	-2270'	Anhydrite & Shale.
2270'	-2410'	Anhydrite & Shale.
2410'	-2510'	Shale & Anhydrite.
2510'	-2635'	Shale & Lime.
2635'	-2805'	Shale & Lime.
2805'	-2890'	Shale & Lime.
2890'	-3030'	Shale & Lime.
3030'	-3200'	Shale & Lime.
3200'	-3320'	Shale & Lime.
3320'	-3365'	Lime.
3365'	-3430'	Lime & Shale Streaks.
3430'	-3488'	Lime.
3488'	-3540'	Lime.
3540'	-3553'	Lime.
3553'	-3578'	Lime.
3578'	-3605'	Lime.
3605'	-3665'	Lime.
3665'	-3745'	Lime.
3745'	-3777'	Shale & Lime.
3777'	-3794'	Conglomerate.
3794'	-3830'	Conglomerate.
3830'	-3864'	Conglomerate & Lime.
3864'	-Total	Depth

PLUSSING
 PLS SEC 26, 10, 20W
 PAGE 118 LINE 20

RECEIVED
 OCT 24 1951
 10-24-1951