

Give All Information Completely
Make Required Affidavit
Mail or Deliver Report to:
Conservation Division
State Corporation Commission
211 No. Broadway
Wichita, Kansas

Rooks County. Sec. 26 Twp. 10 Rge. 20 (NW) (W)

Location as "NE/CNW/SW" or footage from lines SW/SW/SW

Lease Owner Morgenstern & Spector

Lease Name Eliza Well No. #1

Office Address Russell, Kansas

Character of Well (completed as Oil, Gas or Dry Hole) _____

Date well completed _____ 19____

Application for plugging filed Yes 19____

Application for plugging approved Yes 19____


Plugging commenced _____ 7-10 1957

Plugging completed _____ 7-20 1957

Reason for abandonment of well or producing formation _____

If a producing well is abandoned, date of last production _____ 19____

Was permission obtained from the Conservation Division or its agents before plugging was commenced? Yes

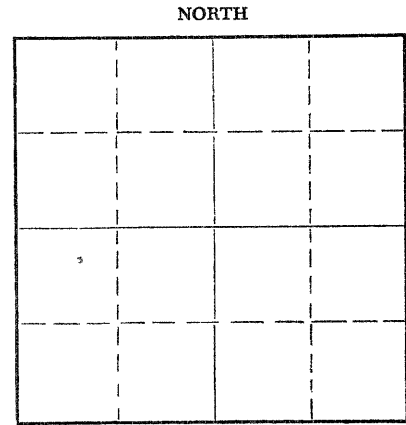

Locate well correctly on above Section Plat

Name of Conservation Agent who supervised plugging of this well Mr. Eldon Petty

Producing formation _____ Depth to top _____ Bottom _____ Total Depth of Well 3749' Feet

Show depth and thickness of all water, oil and gas formations.

OIL, GAS OR WATER RECORDS

CASING RECORD

FORMATION	CONTENT	FROM	TO	SIZE	PUT IN	PULLED OUT
				5 1/2"		3,056'

Describe in detail the manner in which the well was plugged, indicating where the mud fluid was placed and the method or methods used in introducing it into the hole. If cement or other plugs were used, state the character of same and depth placed, from _____ feet to _____ feet for each plug set.

Measured into TD 3749'.
Plugging started 7-10-57. Finished 7-20-57.
Plugged off bottom with sand to 3735' and dumped 5 sacks cement with bailer.
Shot 5 1/2" casing at 3,056'. Pumped 25 sacks mud and circulated. Pulled pipe to 550'. Pumped 35 sacks cement and layed down rest of pipe. Plugged well as follows: Mud to 35'. Set rock bridge and dumped 10 sacks cement for cap on well. Well completed.

(If additional description is necessary, use BACK of this sheet)

Name of Plugging Contractor J.O. Forbes d/b/a Forbes Casing Pulling Co.

Address Box 221, Great Bend, Kansas

STATE OF Kansas, COUNTY OF Barton, ss.
J.O. Forbes (employee of owner) or (owner or operator) of the above-described

well, being first duly sworn on oath, says: That I have knowledge of the facts, statements, and matters herein contained and the log of the above-described well as filed and that the same are true and correct. So help me God.

(Signature) J.O. Forbes
Box 221, Great Bend, Kansas (Address)

SUBSCRIBED AND SWORN TO before me this 29th day of July, 1957.

My commission expires November 8, 1960.

Betty S. Edman Notary Public.

PLUGGING
FILE SEC 26 T. 10 R. 20W
BOOK PAGE 25 LINE 2

STATE CORPORATION COMMISSION
07-31-1957
JUL 31 1957
CONSERVATION DIVISION
WICHITA, KANSAS

WELL LOG BUREAU - KANSAS GEOLOGICAL SOCIETY
 508 E. Hurdock, Wichita, Kansas

COPY

15-163-03151-00-00


Company - GULF OIL CORP.
 Farm - Eliza

No. 1

SEC. 26 T. 10 R. 20W
 SE SE NE

Total Depth. 3749
 Comm. 1-30-50 Comp. 2-21-50
 Shot or Treated. 500 gals.
 Contractor.
 Issued. 4-22-50

County. Rooks
 KANSAS

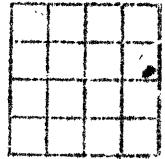

Elevation. _____

Production. Pot. 437 bbls.

CASING:

8 5/8" 1609' cem w/610 sx.
 5 1/2" 3747' cem w/100 sx.

Figures Indicate Bottom of Formations.

shale, shells	1000
red bed	1190
shale, shells	1500
shale, red bed	1600
anhyd.	1655
shale, shells	2215
lime, shale	2500
li e	2775
lime, shale	3260
li e	3565
lime, shale	3660
congl., shale	3706
lime, shale	3749
Total depth	

Tops:	
Heebner	3398
Lansing	3437
Base K.C.	3658
Cong.	3682
Simpson	3726
Arbuckle	3743

RECEIVED
 STATE CORPORATION COMMISSION
 07-02-1957

CONSERVATION COMMISSION
 Kansas

PLUGGING
 FILE SEC. 26 T. 10 R. 20W
 BOOK PAGE 25 LINE 2