


Give All Information Completely
Make Required Affidavit
Mail or Deliver Report to:
Conservation Division
State Corporation Commission
212 No. Market
Wichita, Kansas

WELL PLUGGING RECORD

NORTH

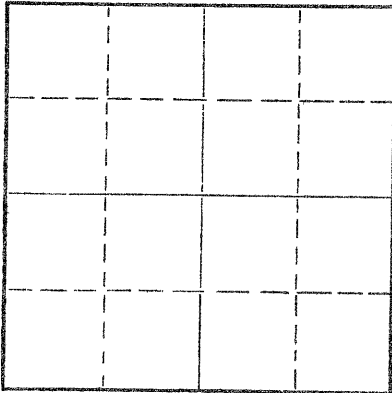

Locate well correctly on above
Section Plat

Sheridan County. Sec. 3 Twp. 9 Rge. 28 (E) W (W)
Location as "NE/CNW%SW%" or footage from lines C SE SE
Lease Owner Herman George Kaiser
Lease Name Farber Well No. 1
Office Address 909 Palace Building, Tulsa, Oklahoma 74100
Character of Well (completed as Oil, Gas or Dry Hole) Dry Hole
Date well completed 2-11 19 69
Application for plugging filed 2-11 19 69
Application for plugging approved 2-11 19 69
Plugging commenced 2-11 19 69
Plugging completed 2-11 19 69
Reason for abandonment of well or producing formation Dry Hole

If a producing well is abandoned, date of last production 19
Was permission obtained from the Conservation Division or its agents before plugging was commenced? Yes

Name of Conservation Agent who supervised plugging of this well W. L. Nichols
Producing formation _____ Depth to top _____ Bottom _____ Total Depth of Well _____ Feet
Show depth and thickness of all water, oil and gas formations.

OIL, GAS OR WATER RECORDS

CASING RECORD

FORMATION	CONTENT	FROM	TO	SIZE	PUT IN	PULLED OUT
Surface Pipe				8 5/8"	257'	

Describe in detail the manner in which the well was plugged, indicating where the mud fluid was placed and the method or methods used in introducing it into the hole. If cement or other plugs were used, state the character of same and depth placed, from _____ feet to _____ feet for each plug set.

1st. plug was set @ 1435' with 100 sacks cement
2nd. plug was set @ 275' with 20 sacks cement
3rd. plug was set @ 40' with 10 sacks cement
Cementing to bottom of cellar

RECEIVED
STATE CORPORATION COMMISSION
FEB 13 1969
CONSERVATION DIVISION
Wichita, Kansas
02-13-1969

(If additional description is necessary, use BACK of this sheet)
Name of Plugging Contractor L. J. Dreiling & Sons, Inc.
Address Route 2, Victoria, Kansas 67671

STATE OF KANSAS, COUNTY OF ELLIS, ss.

L. Leo F. Dreiling (employee of owner) or (owner or operator) of the above-described well, being first duly sworn on oath, says: That I have knowledge of the facts, statements, and matters herein contained and the log of the above-described well as filed and that the same are true and correct. So help me God.

(Signature) [Signature]
LEO F. DREILING, ROUTE 2, VICTORIA, KANSAS 67671
(Address)

SUBSCRIBED AND SWORN TO before me this 12th day of February, 1969

My commission expires September 19, 1970

[Signature]
JOSEPH A. HESS Notary Public.

L. J. DREILING AND SONS, INC.

Victoria, Kansas 67671

WELL LOG

Company Herman George Kaiser 15-179-20182-00-00
909 Palace Building
Tulsa, Oklahoma 74100 Sec. 3 Twp. 9 Rng. 28

Farm Farber No. 1 Location C SE SE

Total Depth 4175' County Sheridan

Comm. 2-5-69 Comp. 2-11-69 Elevation: 2768' K. B.
2765' D. F.
2763' G. R.

Contractor L. J. Dreiling & Sons, Inc.
Victoria, Kansas 67671 Production: D & A

Casing Record Cement Record
257' - 8 5/8" 185 sacks cement

Figures Indicate Bottom of Formations

0'	70'	Sand & Top Soil
70'	135'	Shale
135'	140'	Hard Sand
140'	215'	Sand
215'	230'	Yellow Clay
230'	260'	Blue Shale
260'	1030'	Shale
1030'	1830'	Sand & Shale
1830'	2056'	Shale & Gyp
2056'	2190'	Sand
2190'	2394'	Shale & Redbed
2394'	2407'	Shale
2407'	2752'	Anhy.
2752'	3055'	Shale with Lime Streaks
3055'	3431'	Shale & Lime
3431'	4175'	Lime
4175'	T.D.	

RECEIVED
STATE CORPORATION COMMISSION
FEB 13 1969
CONSERVATION DIVISION
Wichita, Kansas
02-13-1969

STATE OF KANSAS)
)ss
COUNTY OF ELLIS)

I, Leo F. Dreiling, of the L. J. Dreiling & Sons, Inc., upon oath states that the above and foregoing is a true and correct copy from the Daily Drilling Report from your Farber #1.


LEO F. DREILING

Subscribed and sworn to before me this 12th day of February 1969.


JOSEPH A. HESS NOTARY PUBLIC

My commission expires: September 19, 1970

JOSEPH A. HESS
NOTARY PUBLIC
COUNTY OF ELLIS