


STATE OF KANSAS  
STATE CORPORATION COMMISSION

Give All Information Completely  
Make Required Affidavit  
Mail or Deliver Report to:  
Conservation Division  
State Corporation Commission  
212 North Market, Insurance Bldg.  
Wichita, Kansas

WELL PLUGGING RECORD

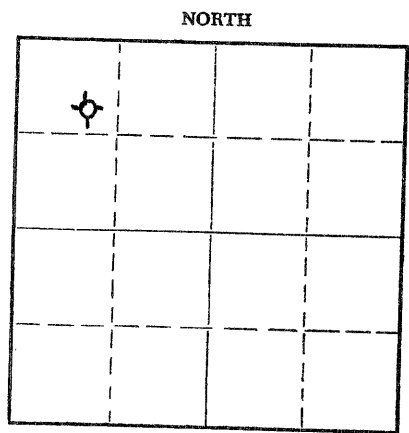

Locate well correctly on above  
Section Plat

Sheridan County. Sec. 3 Twp. 9S Rge. 28 (E) (W)  
Location as "NE/CNW/SW" or footage from lines SE NW NW  
Lease Owner Texas Oil & Gas  
Lease Name Farber Estate Well No. #1  
Office Address 200 West Douglas Suite 300 Wichita, Kansas 67202  
Character of Well (completed as Oil, Gas or Dry Hole) Dry Hole  
Date well completed 11-18-78  
Application for plugging filed Yes 19  
Application for plugging approved 19  
Plugging commenced 19  
Plugging completed 10:00 P.M. 11-18-78 19  
Reason for abandonment of well or producing formation 19

If a producing well is abandoned, date of last production 19  
Was permission obtained from the Conservation Division or its agents before plugging was commenced? Yes

Name of Conservation Agent who supervised plugging of this well Gilbert Balthazor  
Producing formation \_\_\_\_\_ Depth to top \_\_\_\_\_ Bottom \_\_\_\_\_ Total Depth of Well \_\_\_\_\_ Feet  
Show depth and thickness of all water, oil and gas formations.

OIL, GAS OR WATER RECORDS

FORMATION	CONTENT	CASING RECORD				
		FROM	TO	SIZE	PUT IN	PULLED OUT

Describe in detail the manner in which the well was plugged, indicating where the mud fluid was placed and the method or methods used in introducing it into the hole. If cement or other plugs were used, state the character of same and depth placed, from \_\_\_\_\_ feet to \_\_\_\_\_ feet for each plug set.

Plug #1 1200/70 sx. Cement  
Plug #2 240/20 sx. Cement  
Plug #3 40/10 sx. Cement  
2 sx. in Rat Hole

RECEIVED  
STATE CORPORATION COMMISSION  
NOV 29 1978  
11-29-1978  
CONSERVATION DIVISION  
WICHITA, KANSAS

Name of Plugging Contractor John O. Farmer, Inc. (If additional description is necessary, use BACK of this sheet)  
Address Box 352 Russell, Kansas 67665

STATE OF Kansas, COUNTY OF Russell, ss.  
John O. Farmer (employee of owner) or (owner or operator) of the above-described well, being first duly sworn on oath, says: That I have knowledge of the facts, statements, and matters herein contained and the log of the above-described well as filed and that the same are true and correct. So help me God.

(Signature) John O. Farmer  
Box 352 Russell, Kansas 67665 (Address)

SUBSCRIBED AND SWORN TO before me this 28th day of November, 19 78  
My commission expires February 15, 1979  
Helen Carlson  
Notary Public.  
ROBERTS—HUTCHINSON, KS.



**IMPORTANT**  
 Kans. Geo. Survey request  
 samples on this well.

**KANSAS DRILLERS LOG**

S. 3 T. 9 R. 28 <sup>N</sup>/<sub>W</sub>  
 Loc. SE NW NW 990' FNL &  
990' FWL  
 County Sheridan

API No. 15 — 179 — 20,524 - 00 - 00  
County Number

Operator  
Texas Oil & Gas Corp.

Address  
300 - 200 West Douglas Wichita, Kansas 67202


Well No. #1 Lease Name Farber Estate

Footage Location  
990 feet from (N) (S) line 990 feet from (E) (W) line

Principal Contractor John O. Farmer, Inc. Geologist High Plains Consulting, Ltd.

Spud Date 11-07-78 Total Depth 4380' P.B.T.D. N/A

Date Completed 11-18-78 Oil Purchaser N/A

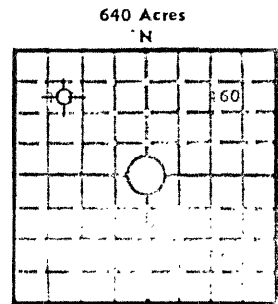

Locate well correctly  
 Elev.: Gr. 2653'  
 DF \_\_\_\_\_ KB 2658'

**CASING RECORD**

Report of all strings set — surface, intermediate, production, etc.

Purpose of string	Size hole drilled	Size casing set (in O.D.)	Weight lbs/ft.	Setting depth	Type cement	Sacks	Type and percent additives
Surface	12 1/4"	8-5/8"	28#	260'	Common	200	2% Gel, 3% CaCl

**LINER RECORD**

**PERFORATION RECORD**

Top, ft.	Bottom, ft.	Sacks cement	Shots per ft.	Size & type	Depth interval
N/A	N/A	N/A			
<b>TUBING RECORD</b>			N/A	N/A	N/A
Size	Setting depth	Packer set at			
N/A	N/A	N/A			

**ACID, FRACTURE, SHOT, CEMENT SQUEEZE RECORD**

Amount and kind of material used	Depth interval treated
N/A	N/A

RECEIVED  
 STATE CORPORATION COMMISSION  
 DEC - 1 1978  
 12-01-1978  
 CONSERVATION DIVISION  
 WICHITA, Kansas

**INITIAL PRODUCTION**

Date of first production N/A Producing method (flowing, pumping, gas lift, etc.) N/A

RATE OF PRODUCTION: PER 24 HOUR	Gas	Water	Gas-oil ratio
<u>N/A</u>	bbls. <u>N/A</u>	MCF <u>N/A</u>	bbls. <u>N/A</u>

Disposition of gas (vented, used on lease or sold) N/A Producing interval(s) N/A

INSTRUCTIONS: As provided in KCC Rule 82-2-125, within 90 days after completion of a well, one completed copy of this Drillers Log shall be transmitted to the State Geological Survey of Kansas, 4150 Monroe Street, Wichita, Kansas 67209. Copies of this form are available from the Conservation Division, State Corporation Commission, 3830 So. Meridian (P.O. Box 17027), Wichita, Kansas 66217. Phone AC 316-522-2206. If confidential custody is desired, please note Rule 82-2-125. Drillers Logs will be on an open file in the Oil and Gas Division, State Geological Survey of Kansas, Lawrence, Kansas 66044.

Operator

Texas Oil &amp; Gas Corp.

15-179-20524-00-00

DESIGNATE TYPE OF COMP.: OIL, GAS,  
DRY HOLE, SWDW, ETC.:

Well No.

1

Lease Name

Farber Estate

Dry Hole

S 3 T 9S R 28W E  
W

## WELL LOG

Show all important zones of porosity and contents thereof; cored intervals, and all drill-stem tests, including depth interval tested, cushion used, time tool open, flowing and shut-in pressures, and recoveries.

SHOW GEOLOGICAL MARKERS, LOGS RUN,  
OR OTHER DESCRIPTIVE INFORMATION.

FORMATION DESCRIPTION, CONTENTS, ETC.	TOP	BOTTOM	NAME	DEPTH
Stone Corral	2289	+369		
Herrington	2672	-14		
Cottonwood	3096	-438		
Topeka	3546	-888		
Heebner	3758	-1100		
Toronto	3780	-1122		
Lansing/Kansas City	3796	-1138		
Plattsburg	3825	-1167		
Drum	3952	-1294		
Dennis	3968	-1310		
Swope	3991	-1333		
Hertha	4015	-1357		
Mississippi	4335	-1677		
TD	4380	-1722		

DST #1, 3767-92', (Tor/Stanton) w/results as follows: IFP/30": 52-52#, weak blow;  
ISIP/60": 1130#; FFP/45": 52-52#, weak blow; FSIP/90": 1120#; Rec 10' SOCM.

DST #2, 3812-40', (Plattsburg) w/results as follows: IFP/30" 42-42#, weak blow;  
ISIP/60": 1265#; FFP/45": 52-52#, fair blow; FSIP/90": 1255#; Rec 10' mud  
w/few specks oil.

DST #3, 3922-70', (Drum/Dennis) w/results as follows: IFP/30": 72-42#, weak blow;  
ISIP/60": 1079#; FFP/45": 62-62#, weak blow; FSIP/90": 799#; Rec 10' SOCM.

RECEIVED  
STATE CORPORATION COMMISSION

JLC - 1 1978

CONSERVATION DIVISION  
Wichita, Kansas

USE ADDITIONAL SHEETS, IF NECESSARY, TO COMPLETE WELL RECORD.

Date Received



HAROLD A. BROWN

Signature

District Geologist

Title

November 29, 1978

Date