


STATE OF KANSAS
STATE CORPORATION COMMISSION

18-179-30063-00-00 Form CP-4

WELL PLUGGING RECORD

Give All Information Completely
Make Required Affidavit
Mail or Deliver Report to:
Conservation Division
State Corporation Commission
212 No. Market
Wichita, Kansas

NORTH

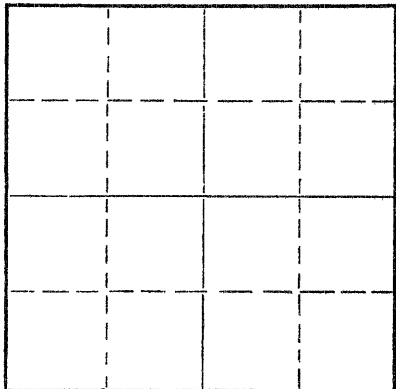

Locate well correctly on above
Section Plat

Sheridan County. Sec. 5 Twp. 9S Rge. (E) 28 (W)

Location as "NE/CNW%SW%" or footage from lines SW NE
Lease Owner Murfin Drilling Company, et al
Lease Name CLARK Well No. 2
Office Address 617 Union Center - Wichita, Kansas
Character of Well (completed as Oil, Gas or Dry Hole) Dry Hole
Date well completed 1-6-66 19
Application for plugging filed 1-6-66 19
Application for plugging approved 1-6-66 19
Plugging commenced 1-6-66 19
Plugging completed 1-6-66 19
Reason for abandonment of well or producing formation Dry Hole

If a producing well is abandoned, date of last production _____ 19____
Was permission obtained from the Conservation Division or its agents before plugging was commenced? yes

Name of Conservation Agent who supervised plugging of this well W. L. Nickols - Morland, Kansas
Producing formation _____ Depth to top _____ Bottom _____ Total Depth of Well 4035 Feet
Show depth and thickness of all water, oil and gas formations.

OIL, GAS OR WATER RECORDS

CASING RECORD

FORMATION	CONTENT	FROM	TO	SIZE	PUT IN	PULLED OUT

Describe in detail the manner in which the well was plugged, indicating where the mud fluid was placed and the method or methods used in introducing it into the hole. If cement or other plugs were used, state the character of same and depth placed, from _____ feet to _____ feet for each plug set.

1st plug @ 600' w/20 sacks
2nd plug @ 150' w/20 sacks
3rd plug @ 40' w/10 sacks

RECEIVED
JAN 12 1966
01-12-1966
WICHITA, KANSAS

(If additional description is necessary, use BACK of this sheet)

Name of Plugging Contractor Murfin Drilling Company
Address 617 Union Center - Wichita, Kansas 67202

STATE OF KANSAS, COUNTY OF SEDGWICK, ss.
C. Robert Buford (employee of owner) or (~~owner or operator~~) of the above-described well, being first duly sworn on oath, says: That I have knowledge of the facts, statements, and matters herein contained and the log of the above-described well as filed and that the same are true and correct. So help me God.

(Signature) MURFIN DRILLING COMPANY
By: C. Robert Buford
C. Robert Buford (Address)

SUBSCRIBED AND SWORN TO before me this 11th day of January, 19 66

My commission expires ADELA MIZENER, Notary Public
My commission expires November 5, 1966

Adela Mizener
Notary Public.


WELL LOG

15-179-30063-00-00

COMPANY Murfin Drilling Company, et al
FARM CLARK NO. 2
RIG. NO. 16
TOTAL DEPTH 4035'
COMM. 12-27-65 COMP. 1-6-66
SHOT OR TREATED
CONTRACTOR Murfin Drilling Company
ISSUED

SEC. 5 T. 9S R. 28W
LOC. SW NE

COUNTRY Sheridan
KANSAS

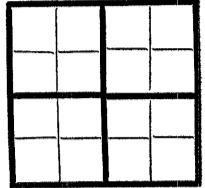

CASING
20 10
15 8 5/8" 127' w/150 sacks
12 6
13 5

ELEVATION 2685 KB

PRODUCTION D&A

FIGURES INDICATE BOTTOM OF FORMATIONS

90 Clay & Sand
130 Blue Shale
1330 Shale
1876 Shale & Sand
2290 Shale & Shells
2325 Anhydrite
2815 Shale
3195 Shale & Lime
3270 Lime & Shale
3326 Lime
3783 Lime & Shale
3971 Lime
4035 Lime & Shale
4035 RTD

RECEIVED
STATE CORPORATION COMMISSION
JAN 12 1966
01-12-1966
CONSERVATION DIVISION
Wichita, Kansas

State of KANSAS
County of SEDGWICK } ss:

I, C. Robert Buford of the Murfin Drilling Company
upon oath state that the above and foregoing is a true and correct copy of the log of the CLARK #2 well.

MURFIN DRILLING COMPANY

By: C. Robert Buford
C. Robert Buford

Subscribed and sworn to before me this 11th day of January 1966

My Commission Expires: ADELA MIZENER, Notary Public
My commission expires November 5, 1966

Adela Mizener
NOTARY PUBLIC