

15-065-02488-00-00

WELL PLUGGING RECORD

STATE OF KANSAS  
STATE CORPORATION COMMISSION


Give All Information Completely  
Make Required Affidavit  
Mail or Deliver Report to:  
Conservation Division  
State Corporation Commission  
800 Bittling Building  
Wichita, Kansas

OR

Strike out upper line  
when reporting plugging  
off formations.

FORMATION PLUGGING RECORD

Graham County. Sec. 1 Twp. 10 Rge. 21 (E) W (NW)  
Location as "NE 1/4 NW 1/4 SW 1/4" or footage from lines. SE 1/4 SW 1/4 SE 1/4  
Lease Owner D. G. Hansen  
Lease Name Muilenburg Well No. 4  
Office Address Logan, Kansas  
Character of Well (completed as Oil, Gas or Dry Hole) Dry Hole  
Date well completed October 6 1949  
Application for plugging filed October 6 1949  
Application for plugging approved October 6 1949  
Plugging commenced October 6 1949  
Plugging completed October 6 1949  
Reason for abandonment of well or producing formation Too low structurally.

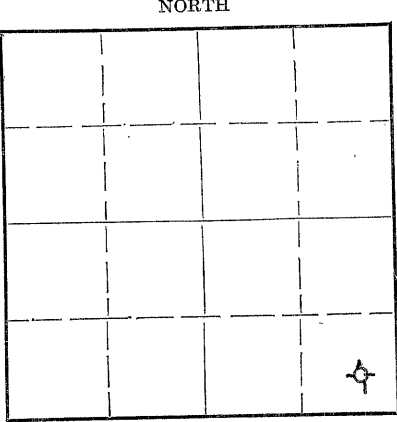

Locate well correctly on above  
Section Plat

Name of Conservation Agent who supervised plugging of this well Eldon Petty, Great Bend, Kansas  
Producing formation --- Depth to top. Bottom. Total Depth of Well. Feet  
Show depth and thickness of all water, oil and gas formations.

OIL, GAS OR WATER RECORDS

CASING RECORD

Formation	Content	From	To	Size	Put In	Pulled Out
				8-5/8"	226.63'	

Describe in detail the manner in which the well was plugged, indicating where the mud fluid was placed and the method or methods used in introducing it into the hole. If cement or other plugs were used, state the character of same and depth placed, from...feet to ...feet for each plug set.  
Filled with drilling mud to 223'. Drove plug to 220'. Put in 15 sacks cement then pumped full of mud 30' from top of hole. Drove plug down to 30' then filled to top with 10 sacks of cement.

RECEIVED  
OCT 8 X 1949  
STATE CORPORATION COMMISSION  
KANSAS

(If additional description is necessary, use BACK of this sheet)


Correspondence regarding this well should be addressed to D. G. Hansen  
Address Logan, Kansas

STATE OF Kansas, COUNTY OF Sedgwick, ss. on  
R. A. Cook, contractor (owner or operator) of the above-described well,  
being first duly sworn on oath, says: That I have knowledge of the facts, statements, and matters herein contained and the log of the above-described well as filed and that the same are true and correct. So help me God.

(Signature) C-G DRILLING COMPANY, Inc.  
206 Union Natl Bank Bldg.  
By R A Cook (Address)

SUBSCRIBED AND SWORN TO before me this 7th day of October, 1949  
Vicky Fritz  
Notary Public.

My commission expires June 25, 1951

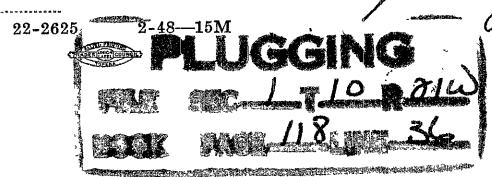

15-065-02488-00-00

CONTRACTOR'S WELL LOG

Operator D. G. Hansen Farm Name Muilenburg No. 4  
Location SE $\frac{1}{4}$  SW $\frac{1}{4}$  SE $\frac{1}{4}$  Sec. 1-10-21W.  
Pool Name Muilenburg County Graham State Kansas  
Commencement Date 9-23-49 Completion Date 10-6-49

LOG OF WELL

All measurements from the top of rotary bushing.


DEPTH		FORMATION	DEVIATION FROM VERTICAL	REMARKS
FROM	TO			
0	225			
225	965	Shale-Shells	500' - 0°	
965	1185	Shale-Shells	1000' - 0°	
1185	1380	Sand-Shale		
1380	1545	Shale-Shells	1500' - 0°	
1545	1685	Shale-Shells		
1685	1727	Anhydrite		
1727	1735	Shale-Shells		
1735	1865	Shale-Shells		
1865	2010	Shale-Shells	2000' - 0°	
2010	2175	Shale-Shells		
2175	2240	Lime-Shale		
2240	2330	Lime-Shale		
2330	2425	Lime-Shale		
2425	2515	Lime-Shale	2500' - 0°	
2515	2580	Lime-Shale		
2580	2645	Lime-Shale		
2645	2720	Shale-Lime		
2720	2790	Shale-Lime		
2790	2890	Shale-Lime		
2890	2935	Lime-Shale		
2935	3000	Lime-Shale		
3000	3080	Lime-Shale	3000' - 0°	
3080	3165	Shale-Lime		
3165	3250	Shale-Lime		
3250	3315	Lime-Shale		
3315	3370	Lime-Shale		
3370	3430	Lime-Shale		
3430	3465	Lime-Shale		
3465	3505	Lime		
3505	3550	Lime		
3550	3574	Lime		
3574	3605	Lime		
3605	3635	Lime		
3635	3705	Lime		
3705	3765	Lime		
3765	3809	Lime		
3809	3855	Lime		
3855	3861	Lime		

10-08-1949  
STATE OF KANSAS  
COMMISSIONER  
KANSAS

CASING LEFT IN HOLE AFTER COMPLETION

Set (10 jts.) 226.63' - 8-5/8" OD Surface Casing

STATE OF KANSAS, COUNTY OF SEDGWICK ) ss.

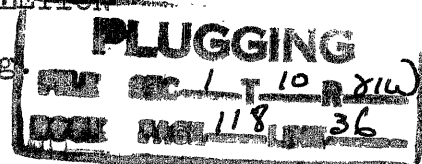

The undersigned certifies that to the best of his knowledge and belief the above facts are true and correct.

C-G DRILLING COMPANY, Inc.

By R. A. Cook, President

Subscribed and sworn to before me this 7th day of October, 1949.

My commission expires:  
June 25, 1951

Vicky Fritz, Notary Public