


Give All Information Completely  
Make Required Affidavit  
Mail or Deliver Report to:  
Conservation Division  
State Corporation Commission  
211 No. Broadway  
Wichita, Kansas

WELL PLUGGING RECORD

NORTH

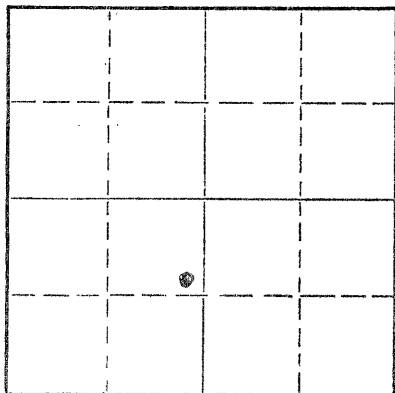

Locate well correctly on above  
Section Plat

Graham County. Sec. 8 Twp. 10 Rge. (E) 21 (W)  
Location as "NE/CNW/SW" or footage from lines SE NE SW  
Lease Owner National Cooperative Refinery Association  
Lease Name Wheeler Well No. 1  
Office Address P. O. Box #6, Great Bend, Kansas 67530  
Character of Well (completed as Oil, Gas or Dry Hole) Oil  
Date well completed July 25, 1957  
Application for plugging filed September 23, 1969  
Application for plugging approved September 24, 1969  
Plugging commenced October 2, 1969  
Plugging completed October 2, 1969  
Reason for abandonment of well or producing formation Depleted

If a producing well is abandoned, date of last production November 11, 1968

Was permission obtained from the Conservation Division or its agents before plugging was commenced? Yes

Name of Conservation Agent who supervised plugging of this well W. L. Nichols

Producing formation Lansing Depth to top 3641 Bottom 3710 Total Depth of Well 3883 Feet

Show depth and thickness of all water, oil and gas formations.

OIL, GAS OR WATER RECORDS


CASING RECORD

FORMATION	CONTENT	FROM	TO	SIZE	PUT IN	PULLED OUT
				8 5/8"	245'	None
				5 1/2"	3882'	None

Describe in detail the manner in which the well was plugged, indicating where the mud fluid was placed and the method or methods used in introducing it into the hole. If cement or other plugs were used, state the character of same and depth placed, from \_\_\_\_\_ feet to \_\_\_\_\_ feet for each plug set.

Globe Cement Company pumped in 1 sack hulls / 50 sacks cement (3600' to 3822') / 13 sacks Gel (400' to 3600') / 25 sacks cement (0' to 400') @ 1500# max. pressure.

SIP 750#. NCRA Representative Earl Baker. COMPLETE @ 2:00 PM October 2, 1969.

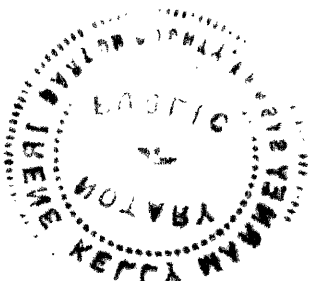

Wheeler #1

15-065-19118-00-00

St. Bend File  
RECEIVED  
STATE CORPORATION COMMISSION

SEP 24 1969  
CONSERVATION DIVISION  
Wichita, Kansas

09-24-1969

Operator: National Cooperative Refinery Association

Contractor: Braden Drilling Company

Test Commenced: June 11, 1957

Test Completed: June 25, 1957

NE KCCap  
SE 82 SW  
Section 8  
Township 10 South  
Range 21 West  
Graham County, Kansas

Casing Record: 7 joints of 8-5/8", set at 245 feet, cemented with 150 sacks of Common cement, 1% G.C.

Sand and Shale	40
Shale and Shells	840
Sand - Dakota	1030
Shale and Shells	1600
Shale	1755
Anhydrite	1785
Redrock and Shale	1800
Shale and Shells	2250
Lime	3850
Shale and Lime	3860
Lime	3883 T. D.

1 2 3 4 5 6 7 8 9 10 11 12 13 14 15 16 17 18 19 20 21 22 23 24 25 26 27 28 29 30 31  
JUL 1957  
RECEIVED  
N.C.R.A.  
Great Bend

State of Colorado )  
County of Denver ) ss.

I hereby certify that the above information is true and correct as revealed by the records of the Braden Drilling Company.

Jeri Hughston

Subscribed and sworn to before me this 28th day of June, 1957.

Helen M. Martin  
Notary Public

My commission expires July 15, 1959.

*[Handwritten signature]*

RECEIVED  
N.C.R.A.  
WICHITA  
JUL 1957