


Give All Information Completely  
Make Required Affidavit  
Mail or Deliver Report to:  
Conservation Division  
State Corporation Commission  
211 No. Broadway  
Wichita, Kansas

WELL PLUGGING RECORD

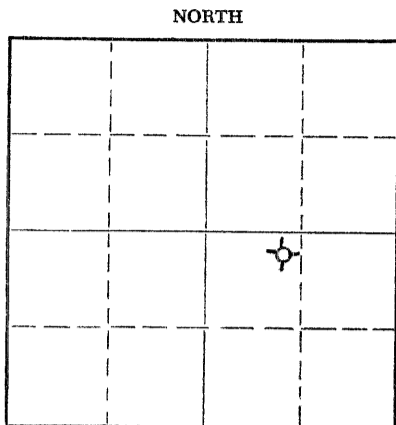

Locate well correctly on above Section Plat

Graham County. Sec. 8 Twp. 10 Rge. 21W (E) (W)  
Location as "NE/CNW/SW" or footage from lines NE NW SE  
Lease Owner D. G. Hansen  
Lease Name Skinner Well No. 2  
Office Address Logan, Kansas  
Character of Well (completed as Oil, Gas or Dry Hole) Dry Hole  
Date well completed June 30 19 59  
Application for plugging filed June 30 19 59  
Application for plugging approved June 30 19 59  
Plugging commenced June 30 19 59  
Plugging completed July 1 19 59  
Reason for abandonment of well or producing formation Too Low structurally

If a producing well is abandoned, date of last production \_\_\_\_\_ 19 \_\_\_\_  
Was permission obtained from the Conservation Division or its agents before plugging was commenced? Yes

Name of Conservation Agent who supervised plugging of this well Eldon Petty, Hays, Kansas  
Producing formation \_\_\_\_\_ Depth to top \_\_\_\_\_ Bottom \_\_\_\_\_ Total Depth of Well 3810 Feet  
Show depth and thickness of all water, oil and gas formations.

OIL, GAS OR WATER RECORDS

CASING RECORD

FORMATION	CONTENT	FROM	TO	SIZE	PUT IN	PULLED OUT
				8-5/8"	175.10'	none

Describe in detail the manner in which the well was plugged, indicating where the mud fluid was placed and the method or methods used in introducing it into the hole. If cement or other plugs were used, state the character of same and depth placed, from \_\_\_\_\_ feet to \_\_\_\_\_ feet for each plug set.

Filled hole with heavy mud to 500'. Set plug. Put in 20 sacks cement. Filled to 175'. Set plug. Put in 1/2 sack hulls and 20 sacks cement. Filled with heavy mud up to 40'. Set plug. Filled to top with 1/2 sack hulls and 10 sacks cement.

RECEIVED  
STATE CORPORATION COMMISSION

FEB 5 1960  
02-05-1960  
CONSERVATION DIVISION  
Wichita, Kansas

(If additional description is necessary, use BACK of this sheet)  
Name of Plugging Contractor C-G Drilling Co.  
Address 107 Rule Building, Wichita 2, Kansas

STATE OF KANSAS, COUNTY OF SEDGWICK, ss.  
G. F. Galloway (employee of owner) or (owner or operator) of the above-described well, being first duly sworn on oath, says: That I have knowledge of the facts, statements, and matters herein contained and the log of the above-described well as filed and that the same are true and correct. So help me God.

(Signature) G. F. Galloway  
107 Rule Building  
(Address)

SUBSCRIBED AND SWORN to before me this 6th day of July, 1959

My commission expires May 20, 1963

Wesley Jacobs  
Notary Public.



*R*  
WELL LOG

OPERATOR D. G. Hansen SEC. 8-10-21W  
 WELL NAME Skinner #2 LOC. NE NW SE  
 TOTAL DEPTH 3810' COUNTY Graham  
 COMM. June 22, 1959 COMP. June 30, 1959 STATE Kansas  
 RIG NO. 1 ELEVATION 2253' R.B.  
 CASING: Ran 175.10' (9 jts.) 8-5/8" OD Surface Casing. PRODUCTION: D & A

All measurements taken from the top of rotary bushing.

FROM	TO	FORMATION	DEVIATION FROM VERTICAL	REMARKS:
0	1450	Sand-Shale		
1450	1767	Red Bed		
1767	1812	Anhydrite		
1812	2360	Shale-Shell		
2360	2515	Shale-Lime	0° - 2500	
2515	2850	Lime-Shale	0° - 2750	
2850	2960	Shale-Lime		
2960	3230	Lime-Shale	0° - 3000	
3230	3345	Lime	0° - 3250	
3345	3520	Lime-Shale		DST 3538-3560'
3520	3700	Lime		DST 3578-3596'
3700	3810	Lime-Shale		DST 3678-3700'

RECEIVED  
 STATE OF KANSAS COMMISSION  
 FEB 5 1960  
 02-05-1960  
 DIVISION

STATE OF KANSAS }  
 COUNTY OF SEDGWICK } SS.

The undersigned hereby certifies that to the best of his knowledge and belief, the above facts are true and correct.

C-G DRILLING CO.  
 By G. F. Galloway  
 G. F. Galloway

SUBSCRIBED AND SWORN TO, BEFORE ME, THIS 6th day of July, 1959.

My commission expires:  
 May 20, 1963

Vicky Jacobs  
 Vicky Jacobs - Notary public