

If production is established pipe will be Cemented immediately from below & down to surface

CARD MUST BE TYPED

State of Kansas  
NOTICE OF INTENTION TO DRILL

(see rules on reverse side)

CARD MUST BE SIGNED

Starting Date: August 7, 1985  
month day year

API Number 15- 179-20,836-00-00

OPERATOR: License # 5141  
Name Zenith Drilling Corporation  
Address 505 Fourth Financial Center  
City/State/Zip Wichita, Kansas 67202  
Contact Person Sherrill Compton  
Phone (316) 265-6697

NE SW SW Sec 27 Twp 9 S, Rge 27  
(location)  East  West

CONTRACTOR: License # 6033  
Name Murfin Drilling Co.  
City/State Wichita, Kansas

990 Ft North from Southeast Corner of Section  
4590 Ft West from Southeast Corner of Section  
(Note: Locate well on Section Plat on reverse side)

Nearest lease or unit boundary line 990 feet.  
County Sheridan

Lease Name White Well# 1

Domestic well within 330 feet:  yes  no  
Municipal well within one mile:  yes  no

Well Drilled For: Well Class: Type Equipment:  
 Oil  Swd  Infield  Mud Rotary  
 Gas  Inj  Pool Ext.  Air Rotary  
 OWWO  Expl  Wildcat  Cable

Depth to Bottom of fresh water 150 feet

Lowest usable water formation Unknown

Depth to Bottom of usable water 150 1400 feet

Surface pipe by Alternate: 1  2

Surface pipe to be set 260 feet

Conductor pipe if any required None feet

Ground surface elevation 2706 feet MSL

This Authorization Expires 1-26-86

Approved By R.H. 7-26-85

If OWWO: old well info as follows:  
Operator  
Well Name  
Comp Date Old Total Depth  
Projected Total Depth 4100 feet  
Projected Formation at TD Base Kansas City  
Expected Producing Formations Lansing-Kansas City

I certify that we will comply with K.S.A. 55-101, et seq., plus eventually plugging hole to K.C.C. specifications.

Date 7-25-85 Signature of Operator or Agent Sherrill Compton Title Vice-President  
Sherrill Compton

Must be filed with the K.C.C. five (5) days prior to commencing well  
 This card void if drilling not started within six (6) months of date received by K.C.C.

RECEIVED  
 STATE CORPORATION COMMISSION


07-26-1985  
 JUL 26 1985

Important procedures to follow:

A Regular Section of Land  
 1 Mile = 5,280 Ft.

CONSERVATION DIVISION  
 Wichita, Kansas

1. Notify District office before setting surface casing.
2. Set surface casing by circulating cement to the top.
3. File completion forms ACO-1 with K.C.C. within 90 days of well completion, following instructions on ACO-1, side 1, and including copies of wireline logs.
4. Notify District office 48 hours prior to old well workover or re-entry.
5. Prior to plugging, prepare a plugging plan, then obtain agreement from the appropriate district office for an approved plugging plan.
6. Submit plugging report (CP-4) to K.C.C. after plugging is completed.
7. Obtain an approved injection docket number before disposing of salt water.
8. Notify K.C.C. within 10 days when injection commences or terminates.
9. If an alternate 2 completion, cement in the production pipe from below any usable water to surface within 120 days of spud date.

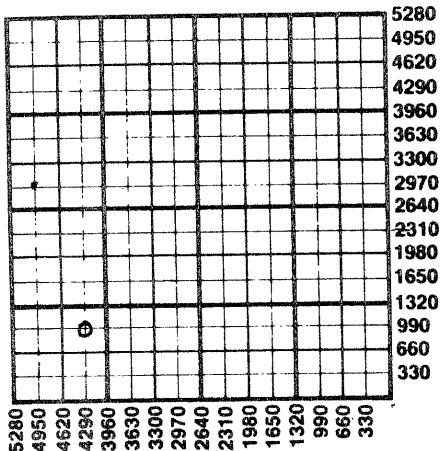

State Corporation Commission of Kansas  
 Conservation Division  
 200 Colorado Derby Building  
 Wichita, Kansas 67202  
 (316) 263-3238