
KANSAS CORPORATION COMMISSION OIL & GAS CONSERVATION DIVISION

WELL PLUGGING APPLICATION

Please TYPE Form and File ONE Copy

Form CP-1 September 2003 This Form must be Typed Form must be Signed All blanks must be Filled

API # 15 - 073 - 22 _ (Identifier Number of this well). This must be listed for wells drilled since 1967; if no API # was issued, indicate original spud or completion date ___09/82 Evans Oil, Inc Well Operator: ____ _KCC License #: __6078 (Owner / Company Name) (Operator's) PO Box 67 Lebo _____ City:___ 66856 Contact Phone: (620)437 -2595 KSState:____ _____ Zip Code:__ Harshman Sec. 8 Twp. 2.3 S. R. 1.3 X East West _____ Well #: SW - SE Spot Location / QQQQ County: Greenwood 330 __ Feet (in exact footage) From North / X South (from nearest outside section corner) Line of Section (Not Lease Line) 1650 Feet (in exact footage) From X East / West (from nearest outside section corner) Line of Section (Not Lease Line) Check One: X Oil Well Cathodic Water Supply Well ENHR Docket # _ NAConductor Casing Size:_ __ Set at: _ __ Cemented with: 8 5/8" Surface Casing Size:__ __ Set at: ___ 150 ' __ Cemented with: ___ NΑ Set at: 1816 ' Production Casing Size:___ _____ Cemented with: ____ N A List (ALL) Perforations and Bridgeplug Sets: 1796'-1802' 13 shots (G.L. / K.B.) T.D.: 1816 PBTD: 1816 Anhydrite Depth: NA Elevation: Condition of Well: X Good Poor Casing Leak Junk in Hole Proposed Method of Plugging (attach a separate page if additional space is needed): Spot plugs down 2 3/8" tubing as 20sxs @ 1700', Perforate 2 shots @ 800', 25sxs @ 800', Perforate 2 shots @ 165'. 45sxs @ 165' to surface RECEIVED KANSAS CORPORATION COMMI Is Well Log attached to this application as required? X Yes No Is ACO-1 filed? Yes No NA DEC 0 6 2007 If not explain why?_ CONSERVATION DIVISION WICHITA, KS Plugging of this Well will be done in accordance with K.S.A. 55-101 et. seq. and the Rules and Regulations of the State Corporation Commission. List Name of Company Representative authorized to be in charge of plugging operations: Clifford Schankie Phone: (620)437 -2595 PO Box 397 City / State: Madison, KS 66860 Plugging Contractor: Schankie Well Service, Inc. KCC License #: 6470 (Contractor's) AddressPO Box 397 Madison, KS 66860 Phone: (620) 437 - 2595 Proposed Date and Hour of Plugging (if known?): ____ 11-09-07 Payment of the Plugging Fee (K.A.R. 82-3-118) will be guaranteed by Operator or Agent 11-09-07 Authorized Operator / Agent: Mail to: KCC - Conservation Division, 130 S. Market - Room 2078, Wichita, Kansas 67202 * Well plugging allready done- nece-blg

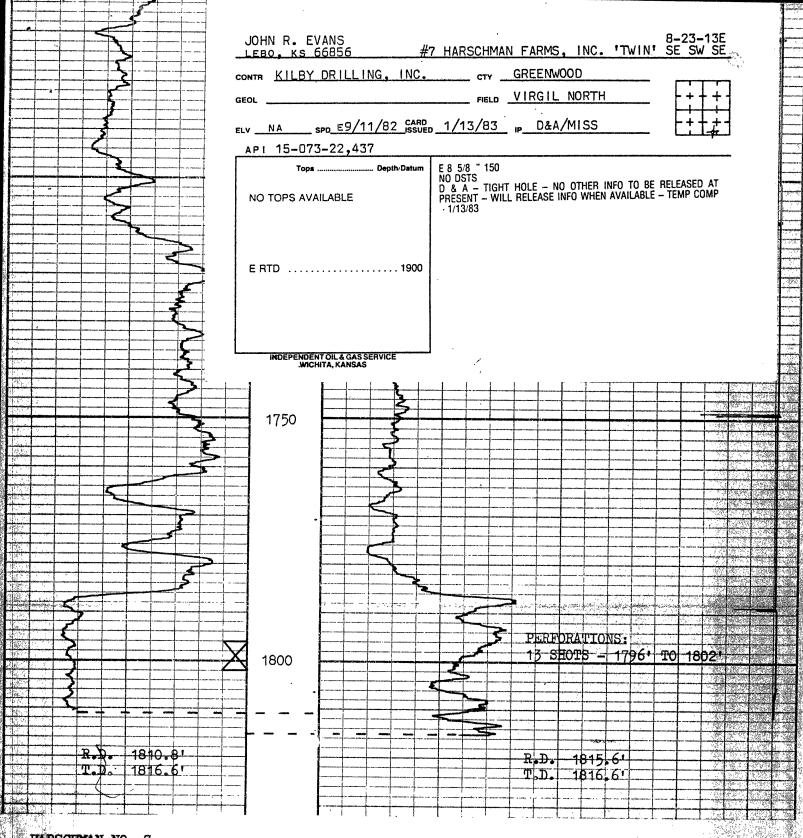

HARSCHMAN NO. 7

JOHN R. EVANS

GREENWOOD COUNTY, KANSAS

MAY 31, 1983

RECEIVED KANSAS CORPORATION COMMIS

DEC 0 6 2007

CONSERVATION DIVISION WICHITA, KS

8/23S/13E

**NSOLIDATED OIL WELL SERVICES, LLC.
.O. BOX 884, CHANUTE, KS 66720
620-431-9210 OR 800-467-8676

TICKET NUMBER	131/9
LOCATION Euneka	
FOREMAN STRUEN	ead Gry Messey

TREATMENT REPORT & FIELD TICKET

CUSTOMER Schankie MAILING ADDRES P.O. 3 a X CITY JOB TYPE P.T. CASING DEPTH SLURRY WEIGHT DISPLACEMENT	31 7	Harsha	ZIP CODE		SECTION TRUCK # 485	DRIVER Alan	TRUCK #	COUNTY CANADASS DRIVER	
SLURRY WEIGHT	TYPE P.T.A HOLE SIZE			HOLE DEPTH CASING SIZ		CASING SIZE &	8 WEIGHT 4/2		
SLURRY WEIGHT	SING DEPTH DRILL PIPE			TUBING 23/8 /700			OTHER		
DISPLACEMENT_	RRY WEIGHTSLURRY VOL			WATER gal/skCEMENT LEF			n CASING		
	PLACEMENT DISPLACEMEN								
EMADKS: C.						Circulation	with Free	Livater.	
22mg 160	70 Sun	Love.	7ab C	omplex-e	Rig down	JU/60' A			
			The	nKYoU					
ACCOUNT	QUANTIT	ITITY or UNITS DESCRIPTION of SERVICES or PRODUCT				ODUCT	UNIT PRICE	TOTAL	
CODE		DUMP CHAPCE				Management of the contract of	550,00	550.00	
5405N			PUMP CHARGE				3.30	99.00	
5496	30		MILEAGE	the course of th	***************************************	ALL MANAGEMENT OF THE PARTY OF	1 3:30	7.700	
	# - 4		+, 1				9 6-5	1112/	
1131	1205k	<u> </u>		Paz Mix	rmeni		9.80	1176.00	
1118A	400 H		Gel!	4%			15	60.00	
#118 A	600₹		Gret spacer				1.15	90.00	
5407	5.1670n2 Tonm			ileage bu	IR Tracks		mic	28500	
								EIVED RATION COMMISS	
						DEC	0 6 2007		
							ATION DIVISION HITA, KS		
				and the second s			SubTotal	2260.00	
								1	
				ARX.	<u> </u>		SALES TAX ESTIMATED TOTAL	83,54	