

KANSAS CORPORATION COMMISSION  
OIL & GAS CONSERVATION DIVISION  
**WELL PLUGGING APPLICATION**  
Please TYPE Form and File ONE Copy

RECEIVED  
KANSAS CORPORATION COMMISSION  
NOV 27 2007  
CONSERVATION DIVISION  
WICHITA, KS

Form CP-1  
September 2003  
This Form must be Typed  
Form must be Signed  
All blanks must be Filled

API # 15 - 187-20,939-00-00 (Identifier Number of this well). This must be listed for wells drilled since 1967; if no API # was issued, indicate original spud or completion date 11-30-00.

Well Operator: Pickrell Drilling Company, Inc. KCC License #: 5123  
(Owner / Company Name) (Operator's)

Address: 100 S. Main, Suite 505 City: Wichita

State: Kansas Zip Code: 67202 Contact Phone: ( 316 ) 262 - 8427

Lease: Naim AC Well #: 2 Sec. 30 Twp. 30S S. R. 40W  East  West

NE - N/2 - NW - SW Spot Location / QQQQ County: Stanton

2460 2536 Feet (in exact footage) From  North /  South (from nearest outside section corner) Line of Section (Not Lease Line)

670 4574 Feet (in exact footage) From  East /  West (from nearest outside section corner) Line of Section (Not Lease Line)

Check One:  Oil Well  Gas Well  D&A  Cathodic  Water Supply Well  
 SWD Docket # \_\_\_\_\_  ENHR Docket # \_\_\_\_\_  Other: \_\_\_\_\_

Conductor Casing Size: \_\_\_\_\_ Set at: \_\_\_\_\_ Cemented with: \_\_\_\_\_ Sacks

Surface Casing Size: 8 5/8 Set at: 1625 Cemented with: 700 Sacks

Production Casing Size: 4 1/2" Set at: 5387 Cemented with: 200 Sacks

List (ALL) Perforations and Bridgeplug Sets: 5355-5358 & 5360-5368

Elevation: 3355 ( G.L. /  K.B.) T.D.: 5389 PBTD: 5384 ~~Analysis~~ Depth: Heebner 3628 (-277)  
(Stone-Coral Formation)

Condition of Well:  Good  Poor  Casing Leak  Junk in Hole

Proposed Method of Plugging (attach a separate page if additional space is needed): Plug back with sand to 5300 ft. Use dump bailer to spot 5 sx. cement on top of sand. Cut and recover casing spotting cement plugs while coming out of hole, as directed by KCC Representative.

Is Well Log attached to this application as required?  Yes  No Is ACO-1 filed?  Yes  No

If not explain why? \_\_\_\_\_

Plugging of this Well will be done in accordance with K.S.A. 55-101 et. seq. and the Rules and Regulations of the State Corporation Commission.

List Name of Company Representative authorized to be in charge of plugging operations: \_\_\_\_\_

Ed Mondero Phone: ( 620 ) 793 - 2315

Address: P.O. Box 375 City / State: Ness City, Kansas 67560

Plugging Contractor: Quality Well Service KCC License #: 31925  
(Company Name) (Contractor's)

Address: 401 West Main, Lyons, Kansas 67554 Phone: ( 620 ) 727 - 3410

Proposed Date and Hour of Plugging (if known?): ~~November 30, 2007~~ Dec - 06 - 07

Payment of the Plugging Fee (K.A.R. 82-3-118) will be guaranteed by Operator or Agent

Date: 11-26-07 Authorized Operator / Agent: \_\_\_\_\_


Mark Gundry  
(Signature)

Mail to: KCC - Conservation Division, 130 S. Market - Room 2078, Wichita, Kansas 67202

\* Well plugged - kcc-dlg

Dist  
1

Company \_\_\_\_\_ Well # 2 Field \_\_\_\_\_ Lease Nairu "A"  
Company Man \_\_\_\_\_ Date Drilled 11/00 County Stanton State Kansas

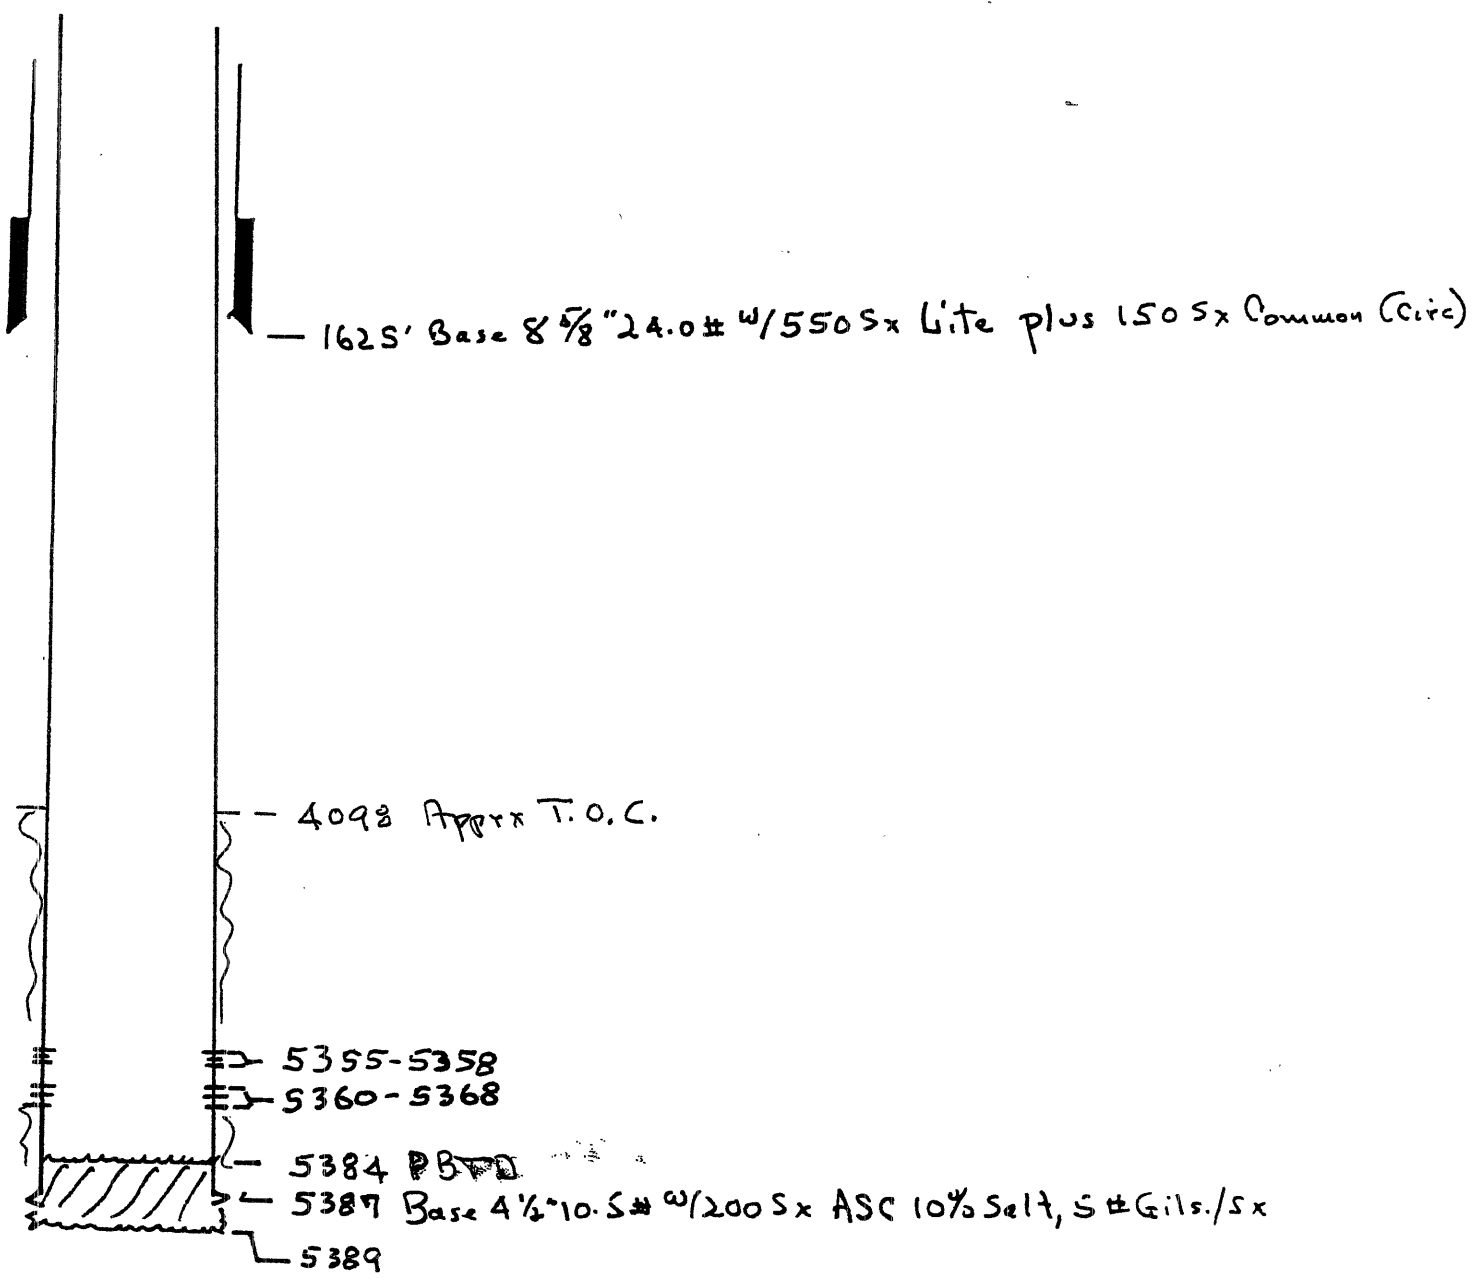

RECEIVED  
KANSAS CORPORATION COMMISSION  
NOV 27 2007  
CONSERVATION DIVISION  
WICHITA, KS

NOV 27 2007

CONSERVATION DIVISION  
WICHITA, KS

CORPORATION COMMISSION

1.6  
KANSAS

Kathleen Sebelius, Governor    Brian J. Moline, Chair    Robert E. Krehbiel, Commissioner    Michael C. Moffet, Commissioner

**NOTICE OF RECEIPT OF WELL PLUGGING APPLICATION (CP-1)**

Pickrell Drilling Company, Inc.  
100 South Main - Suite 505  
Wichita, KS 67202-3738

December 04, 2006

Re: NAIRN-A-C #2  
API 15-187-20939-00-00  
N2NWSW 30-30S-40W, 2540 FSL 670 FWL  
STANTON COUNTY, KANSAS

Dear Operator:

This letter is to notify you that the Conservation Division is in receipt of your plugging proposal, form CP-1, for the above-captioned well.


Your CP-1 has been reviewed by the Conservation Division central office for completeness and to verify license numbers. The plugging proposal will now be forwarded to the district office listed below for review of your proposed method of plugging.

**Please contact the district office for approval of your proposed plugging method at least five (5) days before plugging the well, pursuant to K.A.R. 82-3-113 (b). If a workover pit will be used during the plugging of the well it must be permitted. A CDP-1 form must be filed and approved prior to the use of the pit.**

The Conservation Division's review of form CP-1, either in the central or district office, does not include an inquiry into well ownership or the filing operator's legal right to plug the well.

**This notice in no way constitutes authorization to plug the above-captioned well by persons not having legal rights of ownership or interest in the well. This notice is void after ninety (90) days from the above date.**

Sincerely

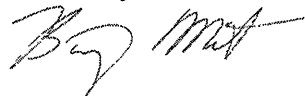

Barry Metz  
Deputy Director

District: #1  
210 E Frontview, Suite A  
Dodge City, KS 67801  
(620) 225-8888

# PICKRELL DRILLING COMPANY, INC.

100 SOUTH MAIN - SUITE 505  
WICHITA, KANSAS 67202-3738  
(316) 262-8427 • FAX (316) 262-0893

November 26, 2007

Well Plugging Application  
Nairn "AC" No. 2  
NE N/2 NW SW, Sec. 30-30S-40W  
Stanton County, Kansas  
API No. 15-187-20939

Kansas Corporation Commission  
Oil & Gas Conservation Division  
130 S. Market, Room 2078  
Wichita, Kansas 67202


Gentlemen:

Enclosed please find our completed Well Plugging Application, Form CP-1, and accompanying well sketch for the captioned well.

This is actually a resubmittal of a previous Application which was submitted approximately one year ago, but which was never acted upon due to unavailability of well plugging equipment. A well plugging unit will be in the area in the next few days and it is our plan to plug this well at that time.

Yours very truly,

PICKRELL DRILLING COMPANY, INC.

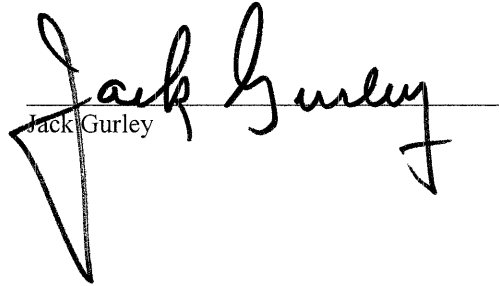  
Jack Gurley

cc: Mike Maier  
Kansas Corporation Commission  
210 E. Frontview, Suite A  
Dodge City, Kansas 67801

Quality Well Service  
401 West Main  
Lyons, KS 67554

Danny Biggs (PDC)

Ed Mondero (PDC)

RECEIVED  
KANSAS CORPORATION COMMISSION

NOV 27 2007

CONSERVATION DIVISION  
WICHITA, KS