


15-163-03032-00-00

STATE OF KANSAS
STATE CORPORATION COMMISSION

WELL PLUGGING RECORD

Give All Information Completely
Make Required Affidavit
Mail or Deliver Report to:
Conservation Division
State Corporation Commission
800 Bitting Building
Wichita, Kansas

Rooks County. Sec. 4 Twp. 9S Rge. (E) 19 (W)
Location as "NE/CNW/SW" or footage from lines NEC SW/4
Lease Owner Westgate-Greenland Oil Company
Lease Name McClellan Well No. C-1
Office Address 1009 Central Building, Wichita, Kansas
Character of Well (completed as Oil, Gas or Dry Hole) oil
Date well completed July 7, 1949 19
Application for plugging filed March 30, 1953 19
Application for plugging approved March 31, 1953 19
Plugging commenced April 15, 1953 19
Plugging completed April 29, 1953 19
Reason for abandonment of well or producing formation oil depleted for commercial production
If a producing well is abandoned, date of last production December 1952
Was permission obtained from the Conservation Division or its agents before plugging was commenced? yes

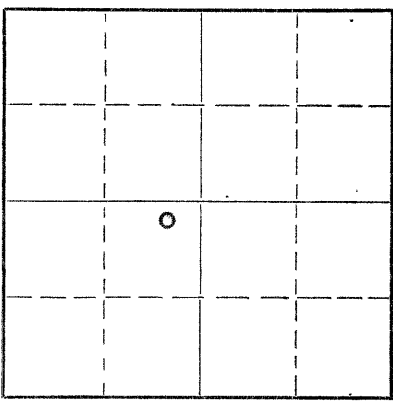

Locate well correctly on above Section Plat

Name of Conservation Agent who supervised plugging of this well Eldon Petty
Producing formation _____ Depth to top _____ Bottom _____ Total Depth of Well _____ Feet
Show depth and thickness of all water, oil and gas formations.

OIL, GAS OR WATER RECORDS

CASING RECORD

FORMATION	CONTENT	FROM	TO	SIZE	PUT IN	PULLED OUT
surface		0	151	10 3/4	151	none
Arbuckle		0	3427	5 1/2"	3427	487 feet

Describe in detail the manner in which the well was plugged, indicating where the mud fluid was placed and the method or methods used in introducing it into the hole. If cement or other plugs were used, state the character of same and depth placed, from _____ feet to _____ feet for each plug set.

Filled hole with rock from total depth to 3415 feet
Ran 4 sacks cement at 3415 to 3375 feet and
Filled with heavy mud to 150 feet and ran 20 sacks
cement to 110 feet. Filled with heavy mud to 20 feet
Ran 10 sacks cement from 20 feet to cellar.

(If additional description is necessary, use BACK of this sheet)

Name of Plugging Contractor Morgan Well Plugging Service
Address 102 West 18th Street, Hutchinson, Kansas

STATE OF Kansas, COUNTY OF Sedgwick, ss.
G. E. Bitler (employee of owner) ~~XXXXXXXXXXXX~~ of the above-described well, being first duly sworn on oath, says: That I have knowledge of the facts, statements, and matters herein contained and the log of the above-described well as filed and that the same are true and correct. So help me God.
(Signature) G. E. Bitler
1009 Central Building, Wichita, Kans
(Address)

SUBSCRIBED AND SWORN to before me this 12th day of May, 19 53
Esther Russell
Notary Public.

My commission expires May 25, 1953.

24-2675-5 2-52-20M



STATE OF KANSAS
5/13/53
MAY 13 1953
CONSERVATION DIVISION
Wichita, Kansas

COMPANY: Westgate Greenland Oil Company
 CONTRACTOR: Jackson Drilling Corporation
 FARM: McClellan C1
 LOCATION: NE Corner of SW/4 Section 4-9-19
 Rooks County, Kansas
 ELEVATION: 1997
 COMMENCED: June 27, 1949
 COMPLETED: July 7, 1949

1	to	155	Top soil - shale - shells
155	to	245	Shale
245	to	880	Shale & shells
880	to	890	Shale
890	to	1130	Sand
1130	to	1405	Red Bed
1405	to	1445	Anhydrite
1445	to	1720	Shale & shells
1720	to	2145	Shale & lime
2145	to	2235	Shale
2235	to	2645	Lime & shale
2645	to	2715	Shale & shells
2715	to	2865	Lime & shale
2865	to	2940	Shale
2940	to	2990	Lime & shale Breaks
2990	to	3115	Lime & shale
3115	to	3195	Lime with shale breaks
3195	to	3403	Lime
3403	to	3420	Shale
3420	to	3429	Shale & arbuckle
		3429 T.D.	

10 3/4" Casing - set at 151 feet - cemented with 100 sacks cement, 1 sack calcium chloride

5 1/2" casing set at 3427 feet - Cemented with 80 sacks cement

Top Arbuckle 3426

Potential - Minimum - physical not yet taken State pot 41 bbls

Measurement taken from top of derrick floor

C E R T I F I C A T E

I, Clare A. Stewart, do hereby certify that the above and foregoing is a true and correct copy of log of the McClellan C1, Section 4-9-19, Rooks County, Kansas, as reflected by files of the Jackson Drilling Corporation.

Clare A. Stewart
 Clare A. Stewart

Subscribed and sworn before me, a Notary Public, within and for Jackson County, Missouri, this 5th day of August, 1949

Vivian M. Garland
 Vivian M. Garland

My Commission expires On August 6, 1950

