


STATE OF KANSAS
STATE CORPORATION COMMISSION
Give All Information Completely
Make Required Affidavit
Mail or Deliver Report to:
Conservation Division
State Corporation Commission
211 No. Broadway
Wichita, Kansas

WELL PLUGGING RECORD

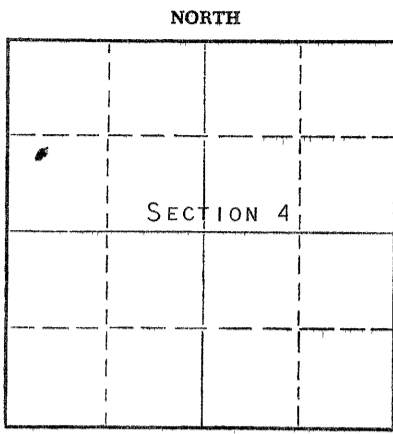

Locate well correctly on above Section Plat

ROOKS County. Sec. 4 Twp. 9s Rge. 19w (E) (W)
Location as "NE/CNW/SW" or footage from lines C N/2 SW NW
Lease Owner PETROLEUM, INC.,
Lease Name ROSTOCIL "B" Well No. 2
Office Address ROUTE 2, GREAT BEND, KANSAS
Character of Well (completed as Oil, Gas or Dry Hole) DRY HOLE
Date well completed AUGUST 30 19 63
Application for plugging filed AUGUST 30, 19 63
Application for plugging approved AUGUST 30, 19 63
Plugging commenced AUGUST 30, 19 63
Plugging completed AUGUST 31, 19 63
Reason for abandonment of well or producing formation NO PRODUCIBLE FORMATIONS

If a producing well is abandoned, date of last production NONE 19
Was permission obtained from the Conservation Division or its agents before plugging was commenced? YES

Name of Conservation Agent who supervised plugging of this well ELDON PETTY
Producing formation - - - Depth to top - - Bottom - - - Total Depth of Well 3491 Feet
Show depth and thickness of all water, oil and gas formations.

OIL, GAS OR WATER RECORDS

CASING RECORD

FORMATION	CONTENT	FROM	TO	SIZE	PUT IN	PULLED OUT
				8-5/8"	255.14'	NONE

Describe in detail the manner in which the well was plugged, indicating where the mud fluid was placed and the method or methods used in introducing it into the hole. If cement or other plugs were used, state the character of same and depth placed, from feet to feet for each plug set.

MUDDED UP WITH HEAVY MUD TO 550', FOLLOWED BY WOODEN PLUG. PLACED 20 SACKS CEMENT THROUGH DRILL PIPE ONTO PLUG. MUDDED UP WITH HEAVY MUD TO 240', FOLLOWED BY WOODEN PLUG. PLACED 20 SACKS CEMENT THROUGH DRILL PIPE ONTO PLUG. MUDDED UP WITH HEAVY MUD TO 40', FOLLOWED BY WOODEN PLUG AND 10 SACKS CEMENT TO BASE OF WELL CELLAR.

RECEIVED
STATE CORPORATION COMMISSION
9/9/63
SEP 9 1963

CONSERVATION DIVISION
Wichita, Kansas

(If additional description is necessary, use BACK of this sheet)
Name of Plugging Contractor GARVEY DRILLING COMPANY
Address ROUTE 2, GREAT BEND, KANSAS

STATE OF KANSAS, COUNTY OF BARTON, ss.
DON SEARLE (employee of owner) or (owner or operator) of the above-described well, being first duly sworn on oath, says: That I have knowledge of the facts, statements, and matters herein contained and the log of the above-described well as filed and that the same are true and correct. So help me God. DON SEARLE, DIST. PROD. SUPT.

(Signature) *Don Searle*
ROUTE 2, GREAT BEND, KANSAS
(Address)

SUBSCRIBED AND SWORN TO before me this 6TH day of SEPTEMBER, 19 63

My commission expires APRIL 14, 1967
Archer J. Miles
Notary Public.

WELL LOG

15-163-19319-00-00

COMPANY Petroleum Inc

SEC. 4 T. 9S R. 19W

FARM Rostocil

NO. B-2

LOC. C N/2 SW NW


TOTAL DEPTH 3491'

COUNTY Rooks

COMM. 8-22-63

COMP. 8-31-63

CONTRACTOR Garvey Drilling Company

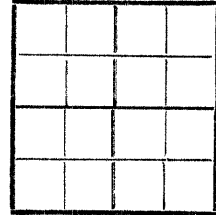

CASING 8 5/8" @ 255.14' w/200 sx

ELEVATION 2027' GL

PRODUCTION D & A

FIGURES INDICATE BOTTOM OF FORMATIONS

- 105' Post Rock and Shale
- 960' Shale and Shells and Sand Streaks
- 1075' Sand
- 1405' Shale and Shells
- 1455' Red Bed
- 1485' Anhydrite
- 1830' Shale
- 2070' Shale and Shells
- 2835' Lime and Shale
- 2985' Shale and Lime Streaks
- 3065' Lime w/Shale
- 3150' Shale and Lime
- 3220' Lime and Shale
- 3233' Lime
- 3255' Lime, Kansas City
- 3469' Lime
- 3491' Arbuckle
- 3491' RTD

RECEIVED
 STATE CORPORATION COMMISSION
 9/9/63
 SEP 9 1963

CONSERVATION DIVISION
 Wichita, Kansas

State of Kansas }
 County of Barton } ss

I, Sam N. Stephens of Garvey Drilling Company
 upon oath state the above and foregoing is a true and correct copy of the log of the Rostocil B-2 well.

Sam N. Stephens

Subscribed and sworn to before me this 6th day of September 19 63

My Commission Expires: April 14th, 1967

Arthur J. Wales
 NOTARY PUBLIC