


STATE OF KANSAS  
STATE CORPORATION COMMISSION

WELL PLUGGING RECORD

Give All Information Completely  
Make Required Affidavit  
Mail or Deliver Report to:  
Conservation Division  
State Corporation Commission  
211 No. Broadway  
Wichita, Kansas

ROOKS County. Sec. 4 Twp. 9S Rge. 19 ~~XX~~ (W)  
NE NW NW

Location as "NE/CNW/SW" or footage from lines  
Lease Owner PETROLEUM, INC.,  
Lease Name ROSTOCIL "B" Well No. 3  
Office Address R. R. #2, GREAT BEND, KANSAS  
Character of Well (completed as Oil, Gas or Dry Hole) DRY HOLE  
Date well completed 11-11- 19 63  
Application for plugging filed 11-11- 19 63  
Application for plugging approved 11-11- 19 63  
Plugging commenced 11-11- 19 63  
Plugging completed 11-11- 19 63  
Reason for abandonment of well or producing formation NO PRODUCIBLE FORMATIONS

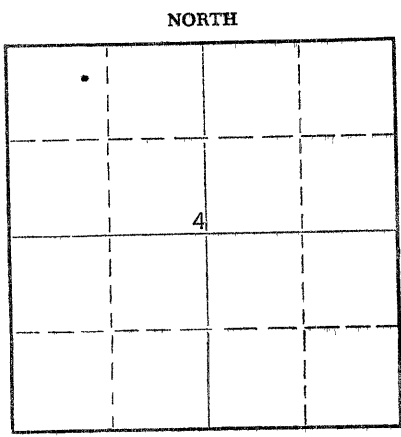

Locate well correctly on above Section Plat

If a producing well is abandoned, date of last production -- -- 19 --  
Was permission obtained from the Conservation Division or its agents before plugging was commenced? YES

Name of Conservation Agent who supervised plugging of this well ELDON PETTY  
Producing formation -- -- Depth to top -- -- Bottom -- -- Total Depth of Well 3190 Feet  
Show depth and thickness of all water, oil and gas formations.

OIL, GAS OR WATER RECORDS

CASING RECORD

FORMATION	CONTENT	FROM	TO	SIZE	PUT IN	PULLED OUT
				NONE	-	-

Describe in detail the manner in which the well was plugged, indicating where the mud fluid was placed and the method or methods used in introducing it into the hole. If cement or other plugs were used, state the character of same and depth placed, from -- -- feet to -- -- feet for each plug set.

MUDDED UP WITH HEAVY MUD TO 550', FOLLOWED BY WOODEN PLUG & 30 SACKS CEMENT. MUDDED UP WITH HEAVY MUD TO 180', FOLLOWED BY A PLUG AND 30 SACKS CEMENT. MUDDED UP WITH HEAVY MUD, FOLLOWED BY A PLUG AND 1/2 SACK HULLS. PUMPED 40 SACKS CEMENT IN HOLE ON TOP OF HULLS TO BASE OF WELL CELLAR.

RECEIVED  
STATE CORPORATION COMMISSION  
11/26/63  
NOV 26 1963

CONSERVATION DIVISION  
Wichita, Kansas

(If additional description is necessary, use BACK of this sheet)  
Name of Plugging Contractor GARVEY DRUG CO.  
Address R. R. #2, GREAT BEND, KANSAS

STATE OF KANSAS, COUNTY OF BARTON, ss.  
MONTE CHADD (employee of owner) or (owner) of the above-described well, being first duly sworn on oath, says: That I have knowledge of the facts, statements, and matters herein contained and the log of the above-described well as filed and that the same are true and correct. So help me God. MONTE CHADD, DIST. PROD. SUPT.

(Signature) Monte Chadd  
R. R. #2, GREAT BEND, KANSAS  
(Address)

SUBSCRIBED AND SWORN TO before me this 21 day of NOVEMBER, 19 63

Notary Public

My commission expires SEPTEMBER 23, 1967

# WELL LOG

15-163-19320-00-00

COMPANY Petroleum Inc.

SEC. 4 T. 9S R. 19W

FARM Rostocil

NO. B-3

LOC. NE NW NW

TOTAL DEPTH 3190'


COUNTY Rooks

COMM. 11-7-63

COMP. 11-11-63

CONTRACTOR Garvey Drilling Company

CASING None

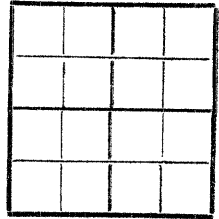

ELEVATION 2020' DF

PRODUCTION D & A

FIGURES INDICATE BOTTOM OF FORMATIONS

60' Clay and Post Rock  
 930' Shale w/Sand Streaks  
 1100' Sand  
 1443' Shale  
 1469' Anhydrite  
 1535' Shale  
 2070' Shale and Shells  
 2185' Shale and Lime  
 3190' Lime and Shale  
 3190' RTD

**RECEIVED**  
 STATE CORPORATION COMMISSION  
 11/26/63  
 NOV 26 1963

CONSERVATION DIVISION  
 Wichita, Kansas

State of Kansas

County of Barton

} SS

I, Sam N. Stephens of Garvey Drilling Company

upon oath state the above and foregoing is a true and correct copy of the log of the Rostocil B-3 well.

*Sam N. Stephens*  
 \_\_\_\_\_

Subscribed and sworn to before me this 16th day of November 19 63

My Commission Expires: September 23rd, 1967

*Howard A. Lewis*  
 \_\_\_\_\_  
 NOTARY PUBLIC