


STATE OF KANSAS
STATE CORPORATION COMMISSION

Give All Information Completely
Make Required Affidavit
Mail or Deliver Report to:
Conservation Division
State Corporation Commission
800 Biting Building
Wichita, Kansas

WELL PLUGGING RECORD

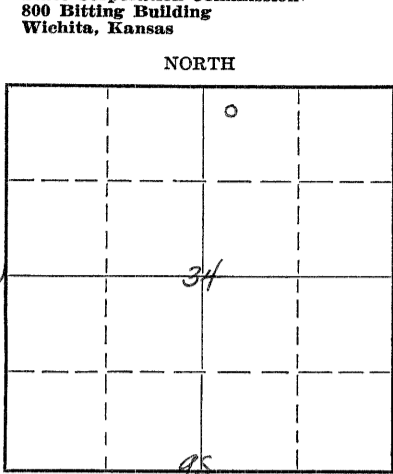

Graham County, Sec. 34 Twp. 9S Rge. 21 W (W)
Location as "NE/CNW 1/4 SW 1/4" or footage from lines NW/4 NW/4 NE/4
Lease Owner Heathman Drilling Co., Inc., et al
Lease Name BLAZER Well No. 1
Office Address 509 Orpheum Building, Wichita, Kansas
Character of Well (completed as Oil, Gas or Dry Hole) dry hole
Date well completed 6-10-1950
Application for plugging filed (verbal) 6-10-1950
Application for plugging approved (verbal - 610-50) written 6-13-1950
Plugging commenced 6-10-1950
Plugging completed 6-10-1950
Reason for abandonment of well or producing formation dry hole

If a producing well is abandoned, date of last production 19
Was permission obtained from the Conservation Division or its agents before plugging was commenced? yes

Name of Conservation Agent who supervised plugging of this well Eldon Petty, Hays, Kansas
Producing formation Depth to top Bottom Total Depth of Well 3957 Feet
Show depth and thickness of all water, oil and gas formations.

OIL, GAS OR WATER RECORDS

CASING RECORD

Formation	Content	From	To	Size	Put In	Pulled Out
		Surface	csg.	8-5/8" (135')	set @ 132'	
				w/90 sacks cement and 1 sack Cal. Chloride.		
				no oil string run - D&A		

Describe in detail the manner in which the well was plugged, indicating where the mud fluid was placed and the method or methods used in introducing it into the hole. If cement or other plugs were used, state the character of same and depth placed, from feet to feet for each plug set.

Filled hole with heavy mud to 120 ft.; set plug and cemented w/40 sacks cement; pipe cut off 3' below level of ground.

6-16-50

(If additional description is necessary, use BACK of this sheet)

Correspondence regarding this well should be addressed to Heathman Drilling Co., Inc.
Address 509 Orpheum Building, Wichita, Kansas


STATE OF Kansas, COUNTY OF Sedgwick, ss.
Robert F. Walters (employee of owner) of the above-described well,
being first duly sworn on oath, says: That I have knowledge of the facts, statements, and matters herein contained and the log of the above-described well as filed and that the same are true and correct. So help me God.

(Signature) Robert F. Walters
509 Orpheum Bldg., Wichita, Kansas (Address)

SUBSCRIBED AND SWORN TO before me this 14th day of June, 1950

D. Marjorie Matt Notary Public.

My commission expires June 28, 1952

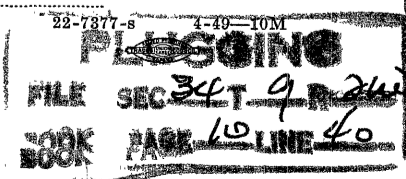

BLAZER NO. 1 WELL

Location: NW/4 NW/4 NE/4 Sec. 34-9S-21W Spudded: 5-30-50
Graham County, Kansas Completed: 6-10-50
Operator: Heathman Drilling Co., Inc. Elevation: 2321' KB
Contractor: Heathman Drilling Co., Inc.
Surface Casing: 4 jts. 8-5/8" (135') set @ 132'
w/ 90 sacks cement and 1 sack
Cal. Chloride.
Oil String: None - D & A

T O P S KB

Anhydrite	1787 (+ 534)
Heebner	3526 (-1205)
Lansing-K.C.	3567 (-1246)
Base K.C.	3788 (-1467)
Conglomerate	3843 (-1522)
Arbuckle	3944 (-1623)
Total Depth	3957 (-1636)

L O G

(Figures indicate bottom of formations)

Clay and sand	0 to 15
Sand shale	132
Shale	740
Shale and sand	1305
Sand	1540
Shale and shells	1752
Shale - Red Bed	1787
Anhydrite	1823
Shale shells	2440
Shale lime	2930
Shale	3206
Shale and lime	3309
Lime	3379
Lime - shale	3483
Lime	3865
Shale, lime and chert	3902
Conglomerate	3924
Chert	3957 T.D.
Total Depth	3957'

The undersigned Robert F. Walters of the Heathman Drilling Co., Inc. hereby certifies that the above is a true and correct log of the formations encountered in drilling the BLAZER No. 1 well as shown on the daily drilling reports.

HEATHMAN DRILLING CO., INC.

BY: Robert F. Walters

Subscribed and sworn before me
this 14th day of June, 1950.

D. Marjorie Matt
Notary Public

My commission expires: June 28, 1952.

