


WELL PLUGGING RECORD

Give All Information Completely
Make Required Affidavit
Mail or Deliver Report to:
Conservation Division
State Corporation Commission
800 Bitting Building
Wichita, Kansas

Graham County. Sec. 34 Twp. 9S Rge. 21 (W)
Location as "NE/CNW $\frac{1}{4}$ SW $\frac{1}{4}$ " or footage from lines SE SE
Lease Owner Blazer
Lease Name Blazer-Yockey Oil Co., Inc. Well No. 1
Office Address Wakeeney, Kansas
Character of Well (completed as Oil, Gas or Dry Hole) Dry
Date well completed May 1, 1951 19.
Application for plugging filed May 4, 1951 19.
Application for plugging approved May 1, 1951 19.
Plugging commenced May 1, 1951 19.
Plugging completed May 1, 1951 19.
Reason for abandonment of well or producing formation dry

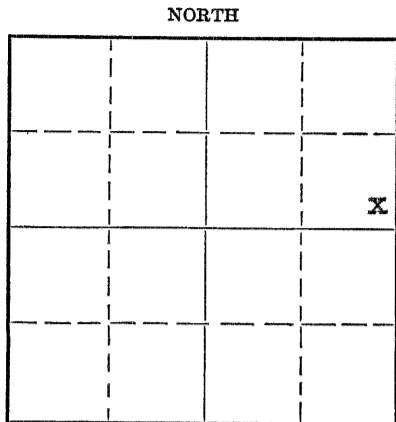

Locate well correctly on above Section Plat

If a producing well is abandoned, date of last production none 19.
Was permission obtained from the Conservation Division or its agents before plugging was commenced? Yes - Phone

Name of Conservation Agent who supervised plugging of this well Eldon Petty
Producing formation no Depth to top Bottom Total Depth of Well Feet
Show depth and thickness of all water, oil and gas formations.

OIL, GAS OR WATER RECORDS

CASING RECORD

Formation	Content	From	To	Size	Put In	Pulled Out
85 ft. to Unknown clay and silt	water and dry	0	174	8 5/8	174	00

Describe in detail the manner in which the well was plugged, indicating where the mud fluid was placed and the method or methods used in introducing it into the hole. If cement or other plugs were used, state the character of same and depth placed, from feet to feet for each plug set.

Bottom plug set at 174 ft. - $\frac{1}{2}$ sack Hulls, 15 sacks Cement - filled with mud to 40 ft. of top. Second plug with $\frac{1}{2}$ sacks Hulls, 10 sacks cement, mixed on top and filled to top.

REC
STATE CORP.

MAY 5 1951
5-5-51
CONSERVATION DIVISION
WICHITA, KANSAS

(If additional description is necessary, use BACK of this sheet)

Correspondence regarding this well should be addressed to Yockey Oil Co., Inc.
Address Wakeeney, Kansas

STATE OF Kansas, COUNTY OF Trego, ss.

Harry T. Osborn (employee of owner) or (owner or operator) of the above-described well, being first duly sworn on oath, says: That I have knowledge of the facts, statements, and matters herein contained and the log of the above-described well as filed and that the same are true and correct. So help me God.

(Signature) Harry T. Osborn July 1951
Wakeeney, Kansas (Address)

SUBSCRIBED AND SWORN to before me this 4th day of May, 1951.

My commission expires Feb 28, 1955 Ernest J. Dennis Notary Public.

PLUGGING
FILE SEC 34 T 9 R 21 W
BOOK PAGE 79 LINE 31

Yockey Oil Co. Inc.
#1 Blazer
SE SE NE, Sec. 34-
9S-21W
Graham County, Kans.

Elevation 2301 KB (2299 DF)

Top Topeka	3293	-992
Top Heebner	3500	-1199
Top Toronto	3524	-1223
Top Lansing	3544	-1243
<i>BASE</i> Top Kansas City	3768	-1461
Top Marmaton	3824	-1523
Top Conglomerate	3880	-1579
Top Arbuckle	3888	-1587
Rotary Total Depth	3901	-1600

PLUGGING
FILE SEC 34 9 21W
BOOK PAGE 79 LINE 31

RECEIVED
MAY 1 1951
5-5-51
DIVISION

YOCKEY OIL CO., INC.

Drilling Royalties and Leases

Hille Bldg.

WAKEENEY, KANSAS

DRILLER'S LOG

Location:

Blazer # 1

SE SE NE 34-9S-21W

Graham County, Kansas

LOG

0	174	Shale
174	1300	Sand
1300	1520	Shale
1520	1675	Sand
1675	1763	Shale
1763	1810	Anhydrite Lime
1810	2049	Redbed shale & shells
2049	2610	Lime & shale
2610	2660	Lime
2660	2775	Lime & shale breaks
2775	2860	Lime & shale
2860	2920	Lime
2920	2965	Lime & shale
2965	3240	Shale & shells
3240	3310	Lime & shale
3310	3660	Hard lime
3660	3901	Lime
3901		Plug Hole

Harry T. Osborn

PLUGGING
 FILE SEC 34 T 9 R 21W
 BOOK PAGE 79 LINE 31

RECEIVED
 JUN 13 1951
 6-13-51