


STATE OF KANSAS
STATE CORPORATION COMMISSION

Give All Information Completely
Make Required Affidavit
Mail or Deliver Report to:
Conservation Division
State Corporation Commission
800 Biting Building
Wichita, Kansas

WELL PLUGGING RECORD

NORTH

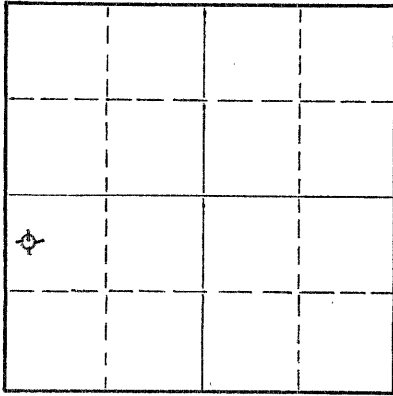

Locate well correctly on above
Section Plat

Graham County, Sec. 34 Twp. 9S Rge. 21 (E) W (W)
Location as "NE/CNW%SW%" or footage from lines C W/2 NW/4 SW/4
Lease Owner C-G DRILLING CO.
Lease Name Kuehnl Well No. 7
Office Address 107 Rule Bldg., Wichita, Kansas
Character of Well (completed as Oil, Gas or Dry Hole) dry hole
Date well completed August 12, 19 55
Application for plugging filed August 12, 19 55
Application for plugging approved August 12, 19 55
Plugging commenced August 13, 19 55
Plugging completed August 13, 19 55
Reason for abandonment of well or producing formation Too low structurally

If a producing well is abandoned, date of last production _____ 19____
Was permission obtained from the Conservation Division or its agents before plugging was commenced? Yes

Name of Conservation Agent who supervised plugging of this well Eldon Petty, Hays, Kansas
Producing formation _____ Depth to top _____ Bottom _____ Total Depth of Well _____ Feet
Show depth and thickness of all water, oil and gas formations.

OIL, GAS OR WATER RECORDS

CASING RECORD

FORMATION	CONTENT	FROM	TO	SIZE	PUT IN	PULLED OUT
				8-5/8"	179.73'	none

Describe in detail the manner in which the well was plugged, indicating where the mud fluid was placed and the method or methods used in introducing it into the hole. If cement or other plugs were used, state the character of same and depth placed, from _____ feet to _____ feet for each plug set.

Filled with heavy mud to 179'. Set plug.
Put in 15 sacks cement, 1/2 sack hulls.
Set plug at 40'. Put in 10 sacks cement.
Filled to top.

REL
STATE CORP. COM.
AUG 20 1955
CONSERVATION DIVISION
Wichita, Kansas

(If additional description is necessary, use BACK of this sheet)
Name of Plugging Contractor Lohmann-Johnson Drilling Co.
Address 320 Indiana Bank Bldg., Evansville, Indiana

STATE OF KANSAS, COUNTY OF SEDGWICK, ss.
G. F. Galloway (employee of owner) or (owner or operator) of the above-described well, being first duly sworn on oath, says: That I have knowledge of the facts, statements, and matters herein contained and the log of the above-described well as filed and that the same are true and correct. So help me God.

(Signature) G. F. Galloway
107 Rule Bldg., Wichita, Kansas
(Address)

SUBSCRIBED AND SWORN TO before me this 14th day of August, 1955

Vicky Jacobs
Notary Public.

My commission expires May 20, 1959

PLUGGING
FILE REC 34 T 9 R 21 W
BOOK PAGE 142 LINE 26

KUEHNL NO. 7
Graham County, Kansas

WELL RECORD

Operator: C-G Drilling Company, Inc.
107 Rule Building
Wichita, Kansas

Contractor: Lohmann-Johnson Drilling Co., Inc.
320 Indiana Bank Building
Evansville, Indiana

Casing: Ran 9 Jts. 8-5/8" Surface Pipe w/150 sacks set @ 179 ft.

Started: August 5, 1955
Completed: August 13, 1955

L O G

<u>FROM</u>	<u>TO</u>	<u>FORMATION</u>
0	180	Sand & Shale
180	1430	Shale, Sand & Shells
1430	1770	Red Bed
1770	1805	Anhydrite
1805	1890	Shale
1890	2665	Lime & Shale
2665	3420	Shale
3420	3505	Lime & Shale
3505	3640	Lime
3640	3679	Lime & Shale
3679	3795	Lime
3795	3845	Lime & Shale
3845	3881	Lime
3881	3915	Lime & Shale
3915		TOTAL DEPTH

Dry and Abandoned - Plugged as of August 13, 1955

The undersigned, Lohmann-Johnson Drilling Company, Inc., hereby certifies that the above Log is a true and correct Log of the formations encountered in drilling the above Wells as reflected by the Daily Drilling Reports.

LOHMANN-JOHNSON DRILLING CO., INC.

By _____

Subscribed and sworn to before me this 16th day of August, 1955

Helen V. Field
Notary Public

My Commission expires November 5, 1957

PLUGGING
FILE SEC 34 9 D 2103
BOOK PAGE 142 LINE 26

RECEIVED
STATE COMMISSION FOR MINING
AUG 22 1955
GAIL W. HARRIS, CLERK