


STATE OF KANSAS
STATE CORPORATION COMMISSION

All Information Completely
Make Required Affidavit
Mail or Deliver Report to:
Conservation Division
State Corporation Commission
211 No. Broadway
Wichita, Kansas

WELL PLUGGING RECORD

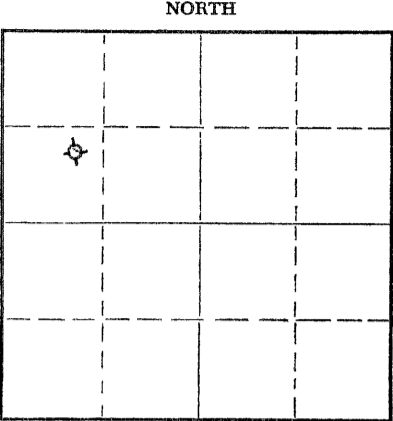

Locate well correctly on above
Section Plat

Graham County. Sec. 34 Twp. 9 Rge. 21 (E) W (W)
Location as "NE/CNW/SW" or footage from lines NE SW NW
Lease Owner Herman Geo. Kaiser
Lease Name Weigel Well No. 1
Office Address 909 Palace Bldg., Tulsa, Oklahoma
Character of Well (completed as Oil, Gas or Dry Hole) Dry Hole
Date well completed November 14 19 56
Application for plugging filed November 14 19 56
Application for plugging approved November 14 19 56
Plugging commenced November 15 19 56
Plugging completed November 15 19 56
Reason for abandonment of well or producing formation Too low structurally

If a producing well is abandoned, date of last production _____ 19____
Was permission obtained from the Conservation Division or its agents before plugging was commenced? Yes

Name of Conservation Agent who supervised plugging of this well Eldon Petty, Hays, Kansas
Producing formation _____ Depth to top _____ Bottom _____ Total Depth of Well 3943 Feet
Show depth and thickness of all water, oil and gas formations.

OIL, GAS OR WATER RECORDS

CASING RECORD

FORMATION	CONTENT	FROM	TO	SIZE	PUT IN	PULLED OUT
				8-5/8"	225'	none

Describe in detail the manner in which the well was plugged, indicating where the mud fluid was placed and the method or methods used in introducing it into the hole. If cement or other plugs were used, state the character of same and depth placed, from _____ feet to _____ feet for each plug set.

Filled hole with heavy mud to 220'. Set plug. Put in 1/2 sack Hulls & 15 sacks cement. Filled with heavy mud up to 40'. Set plug. Filled to top with 1/2 sack Hulls and 10 sacks cement.

RECEIVED
STATE CORPORATION COMMISSION
NOV 21 1956
11-21-56
CONSERVATION DIVISION
Wichita, Kansas

(If additional description is necessary, use BACK of this sheet)
Name of Plugging Contractor C-G Drilling Co.
Address 107 Rule Building, Wichita, Kansas

STATE OF KANSAS, COUNTY OF SEDGWICK, ss.
G. F. Galloway (employee of owner) or (owner or operator) of the above-described well, being first duly sworn on oath, says: That I have knowledge of the facts, statements, and matters herein contained and the log of the above-described well as filed and that the same are true and correct. So help me God.

(Signature) G. F. Galloway
107 Rule Bldg.
(Address)

SUBSCRIBED AND SWORN to before me this 20th day of November, 1956

Vicky Jacobs
Vicky Jacobs
Notary Public.

My commission expires May 20, 1959

PLUGGING
FILE SEC 34 T 9 R21W
BOOK PAGE 116 LI E 27

CONTRACTOR'S WELL LOG

OPERATOR HERMAN GEO. KAISER WELL NAME WEIGEL #1
 LOCATION NE SW NW SECTION 34-9-21W RIG NO. 2
 COUNTY GRAHAM STATE KANSAS
 COMMENCEMENT DATE NOVEMBER 5, 1956 COMPLETION DATE NOVEMBER 14, 1956

LOG OF WELL

Elevation 2338' rotary bushing.
 All measurements taken from the top of rotary bushing.

FROM	TO	FORMATION	DEVIATION FROM VERTICAL	REMARKS
0	225	Shale-Sand		
225	775	Shale		
775	1000	Sand-Shale-		
1000	1550	Shale-Shells		
1550	1645	Red Bed		
1645	1785	Red Bed		
1785	1822	Anhydrite		
1822	2080	Shale-Shells		
2080	2270	Shale-Shells		
2270	2370	Shale-Shells		
2370	2535	Lime-Shale	0° - 2500	
2535	2665	Lime-Shale		
2665	2760	Lime-Shale	0° - 2750	
2760	2945	Shale-Lime		
2945	3115	Shale-Lime	0° - 3000	
3115	3260	Shale-Lime	0° - 3250	
3260	3380	Shale-Lime		
3380	3467	Shale-Lime		
3467	3533	Shale-Lime	0° - 3500	
3533	3600	Lime-Shale		
3600	3675	Lime-Shale		
3675	3785	Lime	0° - 3750	
3785	3878	Lime		
3878	3943	Lime		

CASING LEFT IN HOLE AFTER COMPLETION

Ran 225' (10 jts.) 8-5/8" OD Surface Casing

STATE OF KANSAS }
 COUNTY OF SEDGWICK }

NOV 21 1956
 CONSERVATION DIVISION
 SS. Wichita, Kansas

The undersigned hereby certifies that to the best of his knowledge and belief, the above facts are true and correct.

C-G DRILLING CO.

By Jay H. Galloway
 Jay H. Galloway

Subscribed and sworn to before me this 16th day of November, 1956.

My commission expires:
 May 20, 1959

Vicky Jacobs
 Vicky Jacobs, Notary Public

PLUGGING
 FILE SEC 34 T 9 R 21W
 BOOK PAGE 116 L E 27