


STATE OF KANSAS
STATE CORPORATION COMMISSION

WELL PLUGGING RECORD

Give All Information Completely
Make Required Affidavit
Mail or Deliver Report to
Conservation Division
State Corporation Comm.
245 North Water
Wichita, KS 67202

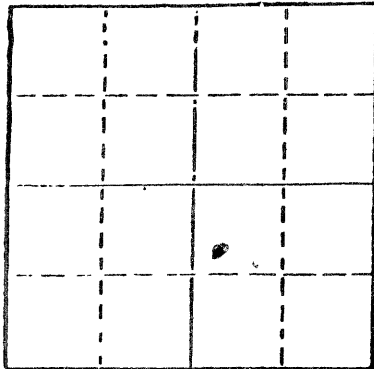

Locate well correctly on above
Section Plot

Graham County. Sec. 34 Twp. 9S Rge. 21 E/W
Location as "NE/CNW $\frac{1}{4}$ SW $\frac{1}{4}$ " or footage from lines
SW NW SE

Lease Owner Bowman Oil Company
Lease Name Desaire Well No. 1
Office Address Codell, Kansas 67630-0037
Character of Well (Completed as Oil, Gas or Dry Hole)
Oil Well

Date Well completed 12/8/77 19
Application for plugging filed 2/6/86 19
Application for plugging approved 2/6/86 19
Plugging commenced 2/6/86 19
Plugging completed 2/6/86 19
Reason for abandonment of well or producing formation
Oil Depleted

If a producing well is abandoned, date of last production
1/1/85 19

Was permission obtained from the Conservation Division or
its agents before plugging was commenced? YES

Name of Conservation Agent who supervised plugging of this well Dennis Hamel
Producing formation Arbuckle Depth to top 3875 Bottom 3879 Total Depth of Well 3879
Show depth and thickness of all water, oil and gas formations.

OIL, GAS OR WATER RECORDS

CASING RECORD

FORMATION	CONTENT	FROM	TO	SIZE	PUT IN	PULLED OUT
				8 5/8	345.88	None
				5 1/2	3875.00	None

Describe in detail the manner in which the well was plugged, indicating where the mud fluid
was placed and the method or methods used in introducing it into the hold. If cement or other
plugs were used, state the character of same and depth placed, from feet to
feet for each plug set. Down 5 $\frac{1}{2}$ " casing at 500# max pressure, mixed
25 sx cement w/1 sacks hulls, 24 sacks gel with 2 sacks hulls, released plug,
and then 100 sacks of cement with 1 sack hulls and shut in.
A nnulus was full, pressured to 1500#.

(If additional description is necessary, use BACK of this sheet)

Name of Plugging Contractor Allied Cemeneting Company, Inc.


STATE OF Kansas COUNTY OF Rooks, ss.
Louis D. Bowman (employee of owner) or (owner or operator)
of the above-described well, being first duly sworn on oath, says: That I have knowledge of
the facts, statements, and matters herein contained and the log of the above-described well
as filed and that the same are true and correct. So help me God.

(Signature) Louis D. Bowman
101 Petroleum Codell, Ks 67630
(Address)

SUBSCRIBED AND SWORN TO before me this 26th day of March, 1986

Vesta J. Russell
Notary Public.

My commission expires July 17, 1988

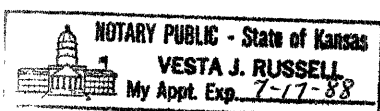

RECEIVED
STATE CORPORATION COMMISSION

MAR 27 1986
3-27-86
CONSERVATION DIVISION
Wichita, Kansas