

9

STATE OF KANSAS
STATE CORPORATION COMMISSION


WELL PLUGGING RECORD

Give All Information Completely
Make Required Affidavit
Mail or Deliver Report to:
Conservation Division
State Corporation Commission
211 No. Broadway
Wichita, Kansas

Graham County, Sec. 34 Twp. 9 Rge. 21 (E) W (W)

Location as "NE/CNW/SW" or footage from lines SE SE SE
Lease Owner Morgenstern & Specter, Inc.
Lease Name Desair Well No. 1
Office Address Russell, Kansas
Character of Well (completed as Oil, Gas or Dry Hole) _____
Date well completed _____ 19____
Application for plugging filed _____ 19____
Application for plugging approved _____ 19____
Plugging commenced 12-7-64 _____ 19____
Plugging completed 12-9-64 _____ 19____
Reason for abandonment of well or producing formation Depleted

NORTH

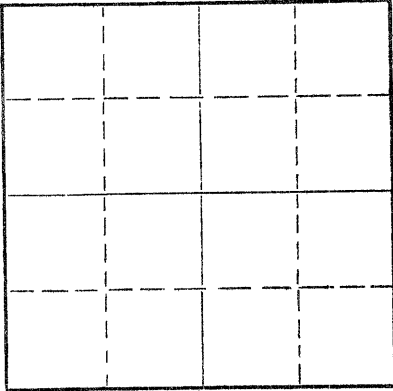

Locate well correctly on above
Section Plat

Name of Conservation Agent who supervised plugging of this well Nichols
Producing formation _____ Depth to top _____ Bottom _____ Total Depth of Well 3862 Feet
Show depth and thickness of all water, oil and gas formations.

OIL, GAS OR WATER RECORDS

CASING RECORD

FORMATION	CONTENT	FROM	TO	SIZE	PUT IN	PULLED OUT
				8-5/8"	1825'	None
				5-1/2"	3855 1/2'	2835'

Describe in detail the manner in which the well was plugged, indicating where the mud fluid was placed and the method or methods used in introducing it into the hole. If cement or other plugs were used, state the character of same and depth placed, from _____ feet to _____ feet for each plug set.

Checked hole to 3862', sanded hole to 3850' and dumped 5 sacks of cement @ 3850' with dump bailer. Pulled 5 1/2" casing, bailed fluid and set rock bridge to 450'. Ran 7 yards of ready mix cement from 450' to base of cellar.

RECEIVED
STATE CORPORATION COMMISSION

DEC 18 1964
12-18-64

CONSERVATION DIVISION
Wichita, Kansas

PLUGGING COMPLETE.

(If additional description is necessary, use BACK of this sheet)
Name of Plugging Contractor KNIGHT CASING PULLING COMPANY
Address CHASE, KANSAS

STATE OF KANSAS, COUNTY OF RICE, ss.
Noel J. Knight (employee of owner) or (owner or operator) of the above-described well, being first duly sworn on oath, says: That I have knowledge of the facts, statements, and matters herein contained and the log of the above-described well as filed and that the same are true and correct. So help me God.

(Signature) Noel J. Knight
Chase, Kansas
(Address)

SUBSCRIBED AND SWORN TO before me this 15th day of December, 1964

My commission expires May 20, 1968

Milton J. Volin
Notary Public.

WELL LOG BUREAU - KANSAS GEOLOGICAL SOCIETY
508 East Murdock, Wichita, Kansas


COPY

Company - PHILLIPS PETROLEUM
Farm - Desair No. 1

SEC. 34 T. 9 R. 22W
SE SE SE

Total Depth. 3862
Comm. 8-11-50 Comp. 9-29-50
Shot or Treated.
Contractor.
Issued. 10-28-50

County. Graham
KANSAS

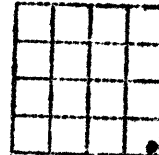

Elevation. 2291 DF

Production. I.P. Phy. 143 BOPD

CASING:

8" 1825'
5" 3855½'

Figures Indicate Bottom of Formations.

sand, shale	437
shale, sand, lime	1215
shale, shells, sand	1545
sand, shale	1755
shale, sand, anhyd.	1806
anhydrite, red bed	1830
redbed, sand, shale	2218
shale, redbed	2391
lime, shale	3120
lime	3360
lime, shale	3560
lime	3703
lime, shale	3823
lime	3844
lime, shale	3862
Total Depth	

Tops:

Howard	3281
Topeka	3309
Heebner	3488
Toronto	3514
Lansing-K.C.	3523
Arbuckle	3853

RECEIVED
STATE CORPORATION COMMISSION

NOV 24 1954

CONSERVATION DIVISION
Wichita, Kansas

Formation Record

Lease Desair

Well No. 1

FROM	TO	Formation	REMARKS
0	437	Sand and Shale	
437	1215	Shale - Sand - Lime	
1215	1545	Shale - Shells - Sand	
1545	1755	Sand - Shale	
1755	1806	Shale - Sand - Anhydrite	Top Anhydrite:
1806	1830	Anhydrite - Redbed	
1830	2218	Redbed - Sand - Shale	
2218	2391	Shale - Redbed	
2391	2679	Lime - Shale	
2679	2920	Sand and Shale	
2920	3120	Lime and Shale	
3120	3360	Lime	
3360	3560	Lime and Shale	
3560	3703	Lime	
3703	3823	Lime and Shale	
3823	3844	Lime	
3844	3862	Lime and Shale	

RECEIVED
STATE CORPORATION COMMISSION

DEC 22 1964

CONSERVATION DIVISION
Wichita, Kansas