


STATE OF KANSAS
STATE CORPORATION COMMISSION

WELL PLUGGING RECORD

Give All Information Completely
Make Required Affidavit
Mail or Deliver Report to
Conservation Division
State Corporation Comm.
245 North Water
Wichita, KS 67202

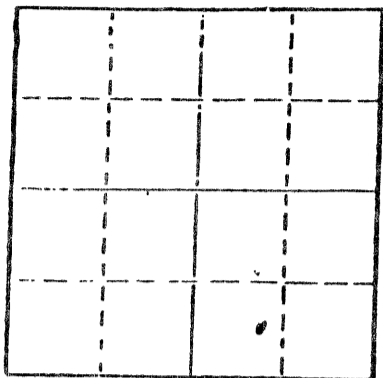

Locate well correctly on above Section Plat

Graham County, Sec. 34 Twp. 9S Rge. 21 E/W
Location as "NE/CNW/SW" or footage from lines
E/2 SW SE

Lease Owner Bowman Oil Company

Lease Name Desaire Well No. 4

Office Address Codell, Kansas 67630-0037

Character of Well (Completed as Oil, Gas or Dry Hole)
OilWell

Date Well completed 12/8/77 19

Application for plugging filed 2/6/86 19

Application for plugging approved 2/6/86 19

Plugging commenced 2/6/86 19

Plugging completed 2/6/86 19

Reason for abandonment of well or producing formation
Oil Depleted

If a producing well is abandoned, date of last production
1/1/85 19

Was permission obtained from the Conservation Division or its agents before plugging was commenced? YES

Name of Conservation Agent who supervised plugging of this well Dennis Hamel

Producing formation Arbuckle Depth to top 3858 Bottom 3860 Total Depth of Well 3887

Show depth and thickness of all water, oil and gas formations.

OIL, GAS OR WATER RECORDS

CASING RECORD

FORMATION	CONTENT	FROM	TO	SIZE	PUT IN	PULLED OUT
				8 5/8	325	None
				5 1/2	3887	None

Describe in detail the manner in which the well was plugged, indicating where the mud fluid was placed and the method or methods used in introducing it into the hold. If cement or other plugs were used, state the character of same and depth placed, from feet to feet for each plug set.

Down 5 1/2" casing, at 750# max pressure.
Mixed: 25 sacks cement w/1 sx hulls, 24 sacks gel w/2 sacks hulls,
released plug and then 100 sacks cement with 1 sack hulls and shut in.
Annulus was full, pressured to 1500#.

(If additional description is necessary, use BACK of this sheet)

Name of Plugging Contractor Allied Cementing Company, Inc.


STATE OF Kansas COUNTY OF Rooks, ss.
Louis D. Bowman (employee of owner) or (owner or operator)
of the above-described well, being first duly sworn on oath, says: That I have knowledge of the facts, statements, and matters herein contained and the log of the above-described well as filed and that the same are true and correct. So help me God.

(Signature) Louis D. Bowman
101 Petroleum Codell, Ks 67630
(Address)

SUBSCRIBED AND SWORN TO before me this 26th day of March, 1986

Vesta J. Russell
Notary Public.

My commission expires July 17, 1988

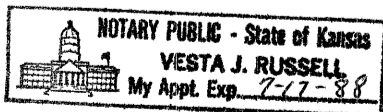

STATE CORPORATION COMMISSION

MAR 27 1986
3-27-86
CONSERVATION DIVISION
Wichita, Kansas