

STATE OF KANSAS  
STATE CORPORATION COMMISSION  
200 Colorado Derby Building  
Wichita, Kansas. 67202

WELL PLUGGING RECORD  
K.A.R.-82-3-117

API NUMBER 15-065-00025-00-01

LEASE NAME Kuehn1

WELL NUMBER 1

990 Ft. from S Section Line

4950 Ft. from E Section Line

SEC. 34 TWP. 9 RGE. 21 (EXOR(W))

COUNTY Graham

Date Well Completed 1/5/41

Plugging Commenced 1/27/87

Plugging Completed 1/27/87

LEASE OPERATOR Bowman Oil Company

ADDRESS Box 17 Codell, Kansas 67630

PHONE# (913) 434-2304 OPERATORS LICENSE NO. 6931

Character of Well SWD

(Oil, Gas, D&A, SWD, Input, Water Supply Well)

Did you notify the KCC/KDHE Joint District Office prior to plugging this well? YES

Which KCC/KDHE Joint Office did you notify? HAYS

Is ACO-1 filed? YES If not, is well log attached? YES

Producing Formation \_\_\_\_\_ Depth to Top \_\_\_\_\_ Bottom \_\_\_\_\_ T.D. \_\_\_\_\_

Show depth and thickness of all water, oil and gas formations.

OIL, GAS OR WATER RECORDS

CASING RECORD

Formation	Content	From	To	Size	Put in	Pulled out
				12 1/2"	250'	None
				8 5/8"	156'	None

Describe in detail the manner in which the well was plugged, indicating where the mud fluid was placed and the method or methods used in introducing it into the hole. If cement or other plugs were used, state the character of same and depth placed, from feet to feet each set.  
Cemented from 1560' to surface with 250 sacks of lite cement with 6 sacks of hulls, final pressure 300#.

(If additional description is necessary, use BACK of this form.)

Name of Plugging Contractor B-J Titan Company License No. \_\_\_\_\_

Address P. O. Box 4442 Houston, Tx 66210 (Hays, Ks Office)

STATE OF Kansas COUNTY OF Rooks, ss.


Louis D. Bowman (Employee of Operator) or (Operator) of above-described well, being first duly sworn on oath, says: That I have knowledge of the facts, statements, and matters herein contained and the log of the above-described well as filed that the same are true and correct, so help me God.

(Signature) Louis D. Bowman

(Address) Box 37 Codell, Ks 67630

SUBSCRIBED AND SWORN TO before me this 2 day of April, 1987

My Commission Expires: 7-17-88  
Vesta J. Russell  
Notary Public

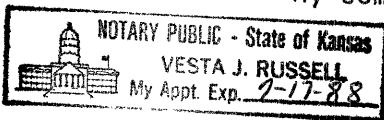

RECEIVED  
STATE CORPORATION COMMISSION  
APR 14 1987  
4-14-87  
CONSERVATION DIVISION  
Wichita, Kansas


Form CP-4  
Revised 08-84

CITIES SERVICE OIL CO.  
 Kuehnl No. 1.

SEC. 34 T. 9 R. 21W  
 NE SW SW  
 990' N 990' E SW Cor.

County. Graham

Total Depth. 3990'  
 Comm. 12-21-40 Comp. 1-5-41  
 Shot or Treated. None  
 Contractor. Hissom & Wolfe Drig. Co.  
 Issued. 3-8-41

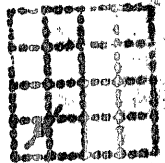

CASING:  
 12 1/2" 250' Cem. 250 M  
 8 5/8" 1561' Cem. 450 M

Elevation. 2325

Production. Dry

Figures Indicate Bottom of Formations.

sand & clay	60
hrd sand & lime shells	110
shale & shells	400
shale	795
shale & shells	870
shale	900
sand	990
shale & shells	1275
sand brkn	1470
shale	1540
lime brkn	1556
anhydrite	1561
lime sdy	1620
redrock & sand shells	1784
lime	1840
red bed	1970
shale	2070
shale hrd	2155
lime & shale	2341
lime	2766
shale & lime	2998
lime	3090
shale & lime	3162
lime brkn & shale	3301
shale & lime shells	3360
lime	3491
lime sdy	3520
lime brkn & sand	3533
lime	3800
shale	3806
lime	3990
Total Depth.	

#1 SWD

Tops:  
 Lansing 3560  
 no shows in Lansing-K.C.  
 Erosional Arbuckle 3934  
 Arbuckle 3970  
 Penetration 20

RECEIVED  
 STATE CORPORATION COMMISSION

APR 14 1987

CONSERVATION DIVISION  
 Wichita, Kansas