


STATE OF KANSAS  
STATE CORPORATION COMMISSION

Give All Information Completely  
Make Required Affidavit  
Mail or Deliver Report to:  
Conservation Division  
State Corporation Commission  
211 No. Broadway  
Wichita, Kansas

WELL PLUGGING RECORD

Graham County, Sec. 10 Twp. 9S Rge. 22 (E) (W)

Location as "NE/CNW%SW%" or footage from lines SE SE NE  
Lease Owner National Cooperative Refinery Association  
Lease Name John Van Loenen Well No. 1  
Office Address 305 Rule Building, Wichita, Kansas  
Character of Well (completed as Oil, Gas or Dry Hole) Dry Hole  
Date well completed July 8, 19 57  
Application for plugging filed July 8, 19 57  
Application for plugging approved July 9, 19 57  
Plugging commenced July 8, 19 57  
Plugging completed July 8, 19 57  
Reason for abandonment of well or producing formation Dry Hole

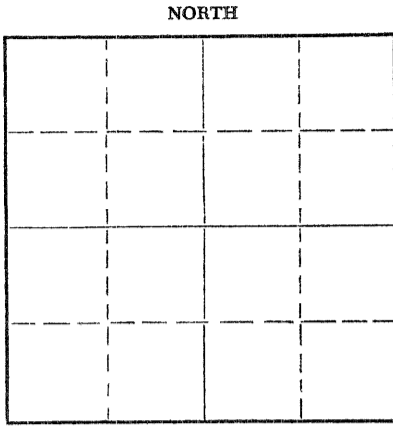

If a producing well is abandoned, date of last production 19  
Was permission obtained from the Conservation Division or its agents before plugging was commenced? Yes

Name of Conservation Agent who supervised plugging of this well Eldon Petty  
Producing formation Depth to top Bottom Total Depth of Well 3896 Feet  
Show depth and thickness of all water, oil and gas formations.

OIL, GAS OR WATER RECORDS

CASING RECORD

FORMATION	CONTENT	FROM	TO	SIZE	PUT IN	PULLED OUT
				8 5/8"	280'	None

Describe in detail the manner in which the well was plugged, indicating where the mud fluid was placed and the method or methods used in introducing it into the hole. If cement or other plugs were used, state the character of same and depth placed, from feet to feet for each plug set.

Mudded hole to 650'. Set bottom plug at 650 feet plus 25 sacks of cement.  
Mudded hole to 40', set plug with 1/2 sack hulls plus 10 sacks of cement, on up to base of cellar.

(If additional description is necessary, use BACK of this sheet)  
Name of Plugging Contractor Braden Drilling Company  
Address Union National Building, Wichita, Kansas

STATE OF Kansas, COUNTY OF Sedgwick, ss.  
C. R. Sears (employee of owner) or (owner/operator) of the above-described well, being first duly sworn on oath, says: That I have knowledge of the facts, statements, and matters herein contained and the log of the above-described well as filed and that the same are true and correct. So help me God.

(Signature) C. R. Sears (C. R. Sears)  
305 Rule Building, Wichita, Kansas  
(Address)

SUBSCRIBED AND SWORN TO before me this 17th day of July, 19 57

My commission expires March 11, 1959. Sharon Z. Howell Notary Public.

PLUGGING  
FILE SEC 10 T 9 R 22W  
BOOK PAGE 25 LINE 32

Van Loenen #1

Operator: National Cooperative Refinery Association

Contractor: Braden Drilling Company

SE SE NE  
10-98-22W  
Graham County, Kansas

Test Commenced: June 25, 1957

Test Completed: July 8, 1957

Casing Record: 7 joints of 8-5/8" casing set at 263 with 150 sacks of Pozmix cement, 2% C.C.

Sand and Shale	70	
Shale and Shells	900	
Sand-Dakota	1190	
Shale and Shells	1780	
Anhydrite	1800	
Shale and Shells	1820	
Lime and Shale	1900	
Red Bed and Shells	2120	
Shale and Shells	2260	
Lime	3000	
Lime and Shale	3300	
Lime	3715	
Lime and Shale	3775	
Lime	3896	T. D.

State of Colorado )  
 ) ss.  
 County of Denver )

I hereby certify that the above information is true and correct as revealed by the records of the Braden Drilling Company.

*Jeri Hughston*

Subscribed and sworn to before me this 11th day of July, 1957.

*Helen M. Martin*  
Notary Public

My commission expires July 15, 1959.



PLUGGING  
 FILE SEC 10 T 9 R 22W  
 BOOK PAGE 25 LINE 32

RECEIVED  
STATE CORPORATION COMMISSION

JUL 18 1957

CONSERVATION DIVISION  
Wichita, Kansas