


STATE OF KANSAS  
STATE CORPORATION COMMISSION

15-127-00067-00-00  
WELL PLUGGING RECORD

Give All Information Completely  
Make Required Affidavit  
Mail or Deliver Report to:  
Conservation Division  
State Corporation Commission  
800 Bitting Building  
Wichita, Kansas

NORTH

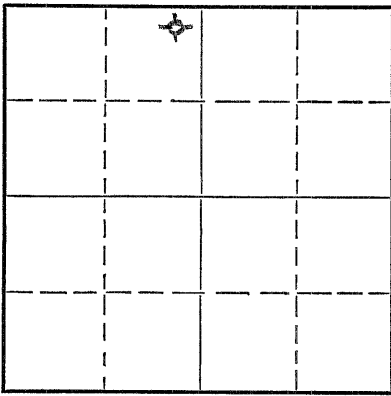

Locate well correctly on above  
Section Plat

Morris County. Sec. 26 Twp. 16S Rge. 5 (E) (W)  
Location as "NE/CNW $\frac{1}{4}$ SW $\frac{1}{4}$ " or footage from lines ne ne nw  
Lease Owner Koester & Mergen  
Lease Name Willms "A" Well No. 1  
Office Address 302 Orpheum Bldg., Wichita, Kansas  
Character of Well (completed as Oil, Gas or Dry Hole) Dry Hole  
Date well completed April 4, 1951 19  
Application for plugging filed April 4, 1951 19  
Application for plugging approved 19  
Plugging commenced 19  
Plugging completed 19  
Reason for abandonment of well or producing formation Dry hole

If a producing well is abandoned, date of last production 19  
Was permission obtained from the Conservation Division or its agents before plugging was commenced? Yes

Name of Conservation Agent who supervised plugging of this well J. D. Robinson  
Producing formation Miss. chat Depth to top 2260 Bottom N. R. Total Depth of Well 2312 Feet  
Show depth and thickness of all water, oil and gas formations.

OIL, GAS OR WATER RECORDS

CASING RECORD

Formation	Content	From	To	Size	Put In	Pulled Out
Miss. chat	H. F. W.	2303	2312	5 $\frac{1}{8}$ "	2261	

Describe in detail the manner in which the well was plugged, indicating where the mud fluid was placed and the method or methods used in introducing it into the hole. If cement or other plugs were used, state the character of same and depth placed, from feet to feet for each plug set.

Poured in 60' heavy mud. Set rock bridge at 185'  
Covered bridge with 12 sacks of cement. Filled hole with heavy mud to near surface. Covered with 5 sacks of cement.

4/14/51  
APR 14 1951  
CONSERVATION DIVISION  
WICHITA, KANSAS

(If additional description is necessary, use BACK of this sheet)

Correspondence regarding this well should be addressed to Koester & Mergen  
Address 302 Orpheum Bldg., Wichita, Kansas

STATE OF Kansas, COUNTY OF Sedgwick, ss.  
J. F. Mergen (employee of owner) or (owner or operator) of the above-described well,

being first duly sworn on oath, says: That I have knowledge of the facts, statements, and matters herein contained and the log of the above-described well as filed and that the same are true and correct. So help me God.

(Signature) J. F. Mergen

(Address)


SUBSCRIBED AND SWORN to before me this 13th day of April, 1951

George A. Schwarz

Notary Public.

My commission expires Nov 29, 1951

23-5091-s 8-50-10M

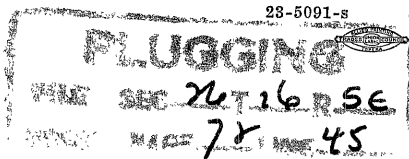

15-127-00067-00-00

Koester & Mergen et al  
No. 1 Willms

26-16-5e, ne ne nw  
Morris County, Kansas  
Dry Hole

Contractor: Slusser Drilling Company

Comm: 3-25-51  
Comp: 4-5-51  
Total Depth: 2312  
Elevation: 1483

8 1/2" casing @168'  
5 1/2" casing @2261'

shale and lime shells	168
lime and shale	565
shale and shells	920
shale and lime	1425
lime	1530
shale	1650
shale and lime	1675
shale	1710
lime	1875
lime and shale	2260
chat	2312

Top of chat 2260'  
Rotary T.D. 2261'

RUST @ 2261

Drilled deeper. LBWPH @ 2281'  
400' water in hole overnight  
@ 2291'

Increase in water 2296-2303'  
700' water in hole @ 2312' in  
two hours.

Time Log:

2200-2210	8-9-8-8-8-9-7-5-6-6
-2220	5-7-7-7-6-8-5-4-4-5
-2230	4-5-5-6-6-6-6-7-7-8
-2240	8-7-8-6-7-7-6-7-5-5
-2250	8-7-8-9-9-13-11-11-11-11
-2260	11-9-8-8-9-9-5-3-4-6
-2261	2

Circ. 30 min. SI rough 60-61.

**PLUGGING**  
BOOK PAGE 72 LINE 45

RECEIVED  
SLUSSER DRILLING COMPANY