


Give All Information Completely
Make Required Affidavit
Mail or Deliver Report to:
Conservation Division
State Corporation Commission
800 Bitting Building
Wichita, Kansas

15-127-0006 B-00-00

WELL PLUGGING RECORD

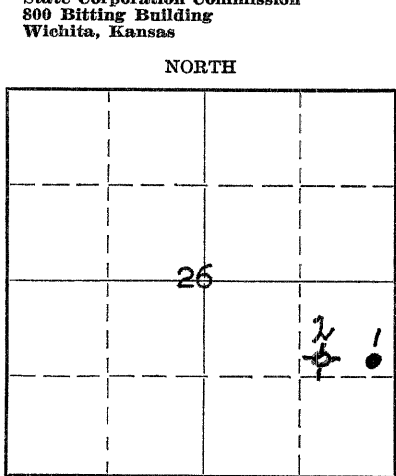

Locate well correctly on above Section Plat

Morris County. Sec. 26 Twp. 16s, Rge. 5e, (E) (W) X
Location as "NE/CNW $\frac{1}{4}$ SW $\frac{1}{4}$ " or footage from lines SW/NE/SE
Lease Owner Koester & Mergen
Lease Name Peterson Well No. 2 A
Office Address 302 Orpheum Building, Wichita, Kansas
Character of Well (completed as Oil, Gas or Dry Hole) Dry Hole
Date well completed January 22, 19 51
Application for plugging filed January 22, 19 51
Application for plugging approved January 22, 19 51
Plugging commenced January 24, 19 51
Plugging completed January 25, 19 51
Reason for abandonment of well or producing formation Dry

If a producing well is abandoned, date of last production 19
Was permission obtained from the Conservation Division or its agents before plugging was commenced? Yes

Name of Conservation Agent who supervised plugging of this well J. D. Robinson, Florence, Kansas
Producing formation Chat Depth to top 2236 Bottom 2291 Total Depth of Well 2292 Feet
Show depth and thickness of all water, oil and gas formations.

OIL, GAS OR WATER RECORDS

CASING RECORD

Formation	Content	From	To	Size	Put In	Pulled Out
Chat	water	2236		4 $\frac{1}{2}$ "	2236 $\frac{1}{2}$	2206 feet
				8 $\frac{1}{2}$ "	157'	none

Describe in detail the manner in which the well was plugged, indicating where the mud fluid was placed and the method or methods used in introducing it into the hole. If cement or other plugs were used, state the character of same and depth placed, from feet to feet for each plug set.

60 buckets mud poured in

Hole bridged at 185 feet, 15 feet rock and mud on top of bridge and 15 sacks cement poured in

Bridged in 8 $\frac{1}{4}$ " surface pipe, rock and mud on bridge and filled to surface with cement.

RECEIVED
STATE CORPORATION COMMISSION
2/20/51
FEB 20 1951
CONSERVATION DIVISION
Wichita, Kansas

(If additional description is necessary, use BACK of this sheet)

Correspondence regarding this well should be addressed to Koester & Mergen
Address 302 Orpheum Bldg., Wichita, Kansas

STATE OF Kansas, COUNTY OF Sedgwick, ss.
J. F. Mergen (owner or operator) of the above-described well,

being first duly sworn on oath, says: That I have knowledge of the facts, statements, and matters herein contained and the log of the above-described well as filed and that the same are true and correct. So help me God.

(Signature) J. F. Mergen
311 Insurance Bldg., Wichita, Kansas (Address)

SUBSCRIBED AND SWORN to before me this 13th day of February, 19 51

My commission expires October 2, 1954

Beverly Larson
Notary Public.

PLUGGING
FILE SEC 26 T16 R5E
BOOK PAGE 57 LINE 11

15-127-00068-00-02

Koester and Mergen
No. 2 Peterson "A"

Cont.: Mendenhall Drlg. Co.

26-16-5E SW NE SE
Morris County, Kansas
Rot. Comm. Dec. 11, 1950
Rot. Compl. Dec. 21, 1950
Abandoned Jan. 24, 1951

8" 165'
1" 2244' 2236 1/4

Soil and Gravel	15	
Shale	25	
Lime	30	
Shale & Lime	148	
water	150	
lime	162	
shale & lime	1015	
lime	1025	
shale & Shells	1140	
Lime	1175	
Shale & lime	1420	
lime	1435	
shale & lime	1480	
lime	1490	
Lime & shale	1535	
lime & shale	1735	
lime	2045	
lime & shale	2115	
lime	2180	
shale & lime	2236	
chat	2239	T.D. Rotary

chat 2291
shale 2292 T. D. D. & A.

2236 1/4

D. C. & D. D. 2240' Rainbow show heavy oil.
D. D. 200' water overnite @ 2248-2256'
Inc. water @ 2267-2274. 800' water overnite
Inc. water @ 2274-2291' 1300' water overnite.
No noticeable increase in oil below 2240'

RECEIVED
STATE CORPORATION COMMISSION
FEB 20 1951
CONSERVATION DIVISION
Wichita, Kansas

PLUGGING
FILE SEC 26Y 16R 56
BOOK PAGE 57 LINE 11