


Give All Information Completely
Make Required Affidavit
Mail or Deliver Report to:
Conservation Division
State Corporation Commission
800 Bittling Building
Wichita, Kansas

OR
FORMATION PLUGGING RECORD

Strike out upper line
when reporting plugging
off formations.

NORTH

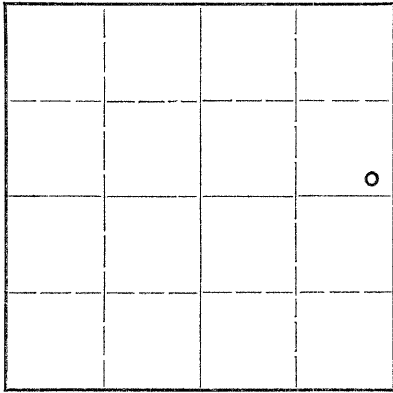

Locate well correctly on above
Section Plat

Location as "NE¹/₄NW¹/₄SW¹/₄" or footage from lines NE, SE, NE County. Monro Sec. 26 Twp. 16 Rge. 5 (E) (W)

Lease Owner D. J. Lund Peterson

Lease Name _____ Well No. 2

Office Address Alta Vista, Kansas

Character of Well (completed as Oil, Gas or Dry Hole)

Date well completed 02 8 1951

Application for plugging filed " 9 1951

Application for plugging approved " 9 1951

Plugging commenced " 9 1951

Plugging completed " 9 1951

Reason for abandonment of well or producing formation dry

If a producing well is abandoned, date of last production _____ 19____

Was permission obtained from the Conservation Division or its agents before plugging was commenced? Yes Robinson

Name of Conservation Agent who supervised plugging of this well _____
Producing formation _____ Depth to top _____ Bottom _____ Total Depth of Well 2273 Feet

Show depth and thickness of all water, oil and gas formations.

OIL, GAS OR WATER RECORDS

CASING RECORD

Formation	Content	From	To	Size	Put In	Pulled Out
				<u>8 5/8</u>	<u>163</u>	—

Describe in detail the manner in which the well was plugged, indicating where the mud fluid was placed and the method or methods used in introducing it into the hold. If cement or other plugs were used, state the character of same and depth placed, from _____ feet to _____ feet for each plug set.

Hole full of mud
Plug at 180' 10 sacks of cement
Plug at top 5 sacks of cement

(If additional description is necessary, use BACK of this sheet)

Correspondence regarding this well should be addressed to _____
Address _____

STATE OF Kansas COUNTY OF Lyon, ss.

Rt. Meidenhall (employee of owner) or (owner or operator) of the above-described well, being first duly sworn on oath, says: That I have knowledge of the facts, statements, and matters herein contained and the log of the above-described well as filed and that the same are true and correct. So help me God.

(Signature) Rt. Meidenhall

1020 W. 15th St., Emporia, Kansas
(Address)

SUBSCRIBED AND SWORN to before me this _____ day of _____, 19____

My commission expires July 22, 1955

Gladden A. Hallin
Notary Public.

Fred J. Phund
 Cont-Mendenhall Sulley Co
 Start Sept 27-1951
 Finish Oct 7-1951

Peterson # 2
 SE, SE, NE
 26-16-5-Morris Co
 163' - 8 5/8

Soot + clay	10	
Sh	37	
Lime	43	
Sand	48	
Shale + lime	140	
Lime	165	
Shale + lime	1756	
Lime	1985	
Shale	2208	
Chat + lime	2273	TD

RECEIVED

26-16-5
 145 29