

STATE OF KANSAS
STATE CORPORATION COMMISSION

WELL PLUGGING RECORD


OR

FORMATION PLUGGING RECORD

Strike out upper line when reporting plugging off formations.

Give All Information Completely
Make Required Affidavit
Mail or Deliver Report to:
Conservation Division
State Corporation Commission
800 Bitting Building
Wichita, Kansas

Location as "NE 1/4 NW 1/4 SW 1/4" or footage from lines
County. Monro Sec. 26 Twp. 16 Rge. 5 (E) (47)

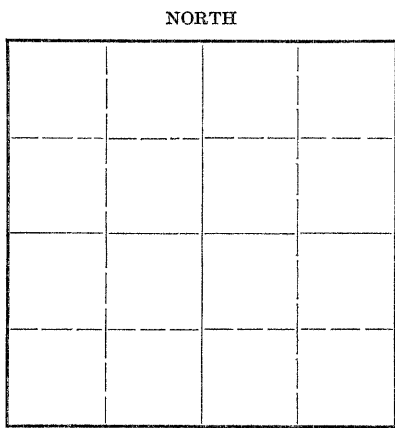

Locate well correctly on above Section Plat

Lease Owner R. Mendenhall
Lease Name Peterson Well No. 1
Office Address Empora
Character of Well (completed as Oil, Gas or Dry Hole) dry
Date well completed Sept 14 1951
Application for plugging filed " " 1951
Application for plugging approved " " 1951
Plugging commenced " " 1951
Plugging completed " " 1951
Reason for abandonment of well or producing formation dry

If a producing well is abandoned, date of last production 19
Was permission obtained from the Conservation Division or its agents before plugging was commenced? Yes

Name of Conservation Agent who supervised plugging of this well Robinson
Producing formation Robinson Depth to top 2281 Bottom 2281 Total Depth of Well 2281 Feet
Show depth and thickness of all water, oil and gas formations.

OIL, GAS OR WATER RECORDS

CASING RECORD

Formation	Content	From	To	Size	Put In	Pulled Out
				<u>8 5/8</u>	<u>146</u> <u>169</u>	<u>#4 None</u>

Describe in detail the manner in which the well was plugged, indicating where the mud fluid was placed and the method or methods used in introducing it into the hold. If cement or other plugs were used, state the character of same and depth placed, from _____ feet to _____ feet for each plug set.

Hole filled with mud plug set 150'
15 sacks cement - 5 sacks on top

RECEIVED
SEP 28 1951
CONSERVATION DIVISION
Wichita, Kansas

(If additional description is necessary, use BACK of this sheet)
Correspondence regarding this well should be addressed to R. Mendenhall
Address Empora, KS

STATE OF Kansas, COUNTY OF LeFlore, SS. R. Mendenhall (employee of owner) or (owner or operator) of the above-described well, being first duly sworn on oath, says: That I have knowledge of the facts, statements, and matters herein contained and the log of the above-described well as filed and that the same are true and correct. So help me God.

(Signature) R. Mendenhall
Empora, KS (Address)

SUBSCRIBED AND SWORN TO before me this 27th day of September, 1951.

Gladden A. Walker
Notary Public.

My commission expires July 30, 1955.

21-6858-RS 2-47-6M
FILE No. 16-56
PAGE 109 LINE 49

15-127-19001-00-00

PEREYSON # 1

Operator - R. L. Mendenhall
Contractor - Mendenhall Drilg. Co.
Start - Sept. 1, 1951
Finish - Sept 14, 1951

SE cor-S $\frac{1}{2}$ -N $\frac{1}{2}$
26-16-5
Morris Co., Kansas
8 5/8 - 169 ft.
Dry.

Shale & Shells	30
Broken lime	71
Shale & Lime	134
Lime	156
Shale & Lime	460
R. R.	470
Shale	485
Shale & Lime	1735
Lime	1770
Lime & Shale	1800
Lime	1960
Shale	1970
Lime	2010
Shale & Shells	2205
Chat	2266
Lime	2281

PLUGGING
FILE REC 76-16-56
BOOK PAGE 109 LINE 44

SEP 28 1951

DIVISION