


STATE OF KANSAS  
STATE CORPORATION COMMISSION

WELL PLUGGING RECORD

Give All Information Completely  
Make Required Affidavit  
Mail or Deliver Report to:  
Conservation Division  
State Corporation Commission  
800 Bitting Building  
Wichita, Kansas

NORTH

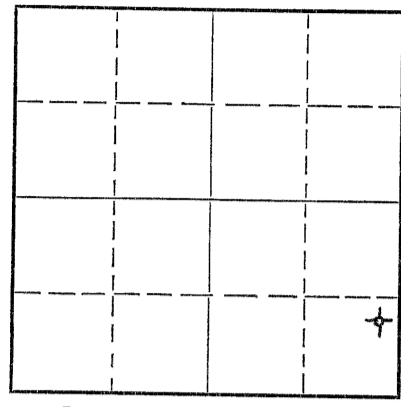

Locate well correctly on above  
Section Plat

Graham County, Sec. 13 Twp 28 Rge 22 (E) W (W)  
Location as "NE/CNW 1/4 SW 1/4" or footage from lines NE SE SE  
Lease Owner Anderson-Prichard Oil Corp.  
Lease Name Buss "D" Well No. 3  
Office Address 1000 Apco Tower, Oklahoma City 2, Oklahoma  
Character of Well (completed as Oil, Gas or Dry Hole) Dry Hole  
Date well completed September 17 19 51  
Application for plugging filed " 17 19 51  
Application for plugging approved " 17 19 51  
Plugging commenced " 17 19 51  
Plugging completed " 17 19 51  
Reason for abandonment of well or producing formation Dry Hole

If a producing well is abandoned, date of last production 19  
Was permission obtained from the Conservation Division or its agents before plugging was commenced? Yes

Name of Conservation Agent who supervised plugging of this well E. R. Petty  
Producing formation Depth to top Bottom Total Depth of Well 3890 Feet  
Show depth and thickness of all water, oil and gas formations.

OIL, GAS OR WATER RECORDS

CASING RECORD

Formation	Content	From	To	Size	Put In	Pulled Out
		0	245'	8 5/8"	245'	None

Describe in detail the manner in which the well was plugged, indicating where the mud fluid was placed and the method or methods used in introducing it into the hole. If cement or other plugs were used, state the character of same and depth placed, from feet to feet for each plug set.

3890' - 211 1/2' - Heavy Rotary Mud  
211 1/2' - 210' - Wooden Plug  
210' - 164' - 15 sacks cement  
164' - 41 1/2' - Heavy Rotary Mud  
41 1/2' - 40' - Wooden Plug  
40' - 6' - 10 sacks cement  
6' - Surface - Cellar

9/22/51

(If additional description is necessary, use BACK of this sheet)

Name of Plugging Contractor Glenn W. Peell  
Address P. O. Box 359  
Hoisington, Kansas

STATE OF Kansas, COUNTY OF Barton, SS.  
GLENN W. PEELL (employee of owner) or ~~owner or operator~~ of the above-described well,

being first duly sworn on oath, says: That I have knowledge of the facts, statements, and matters herein contained and the log of the above-described well as filed and that the same are true and correct. So help me God. GLENN W. PEELL

(Signature) BY: *Way Herbert*  
POST OFFICE BOX 359  
HOISINGTON, KANSAS (Address)

SUBSCRIBED AND SWORN TO before me this 20th day of September, 19 51

My commission expires June 4, 1955  
Marian M. Herbert Notary Public.

PLUGGING  
FILE SEC 13 T 9 R 24  
BOOK PAGE 110 LINE 26

DRILLER'S LOG

Company: Anderson-Prichard Oil Corp.

Farm: Buss "D" Well No. 3  
Total Depth: 3890'

Comm: 9-7-51 Comp: 9-17-51  
Contractor: Glenn W. Peel  
Casing: 8 5/8" 245' cem.

NE SE SE  
Sec. 13, Twp. 9S, Rge. 22W  
County: Graham,  
Kansas

Elevation:  
Production: Dry

Figures below indicate bottom of formations

Surface Clay	0 -	40
Sand & Shale		160
Shale		825
Shale & Sand		1080
Shale & Shells		1785
Anhydrite		1815
Shale & Shells		1945
Shale		2150
Shale & Shells		2480
Lime & Shale		2625
Shale		2905
Lime & Shale		3030
Shale		3120
Lime & Shale		3405
Lime		3420
Lime & Shale		3590
Lime		3805
Conglomerate		3820
Lime		3890
Total Depth		3890

This is to certify that the above information is to the best of my knowledge true and correct.

GLENN W. PEEL

BY: Wm Herbert

SUBSCRIBED AND SWORN to before me this 20<sup>th</sup> day of September, 1951.

My commission expires June 4, 1955

Marian M. Herbert  
Notary Public

SFP 26 311

PLUGGING  
FILE SEC-12 T-9 R-20  
BOOK PAGE 110 LINE 26