


15-065-00907-00-02

STATE OF KANSAS
STATE CORPORATION COMMISSION

Give All Information Completely
Make Required Affidavit
Mail or Deliver Report to:
Conservation Division
State Corporation Commission
211 No. Broadway
Wichita, Kansas

WELL PLUGGING RECORD

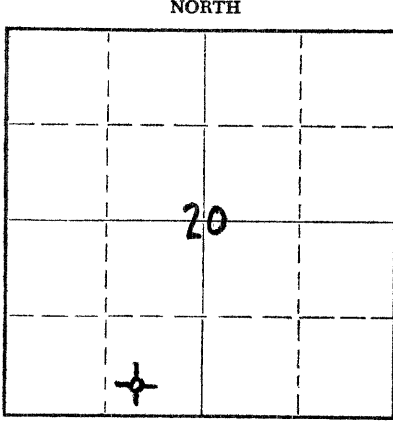

NORTH

Locate well correctly on above
Section Plat

Graham County, Sec. 20 Twp. 9S Rge. 22 (E) 22 (W)

Location as "NE/CNWxSWx" or footage from lines SW SE SW
Lease Owner J. F. Darby Oil Company
Lease Name James Farrell "B" Well No. 1
Office Address 1807 Philtower Bldg., Tulsa, Oklahoma
Character of Well (completed as Oil, Gas or Dry Hole) Dry Hole
Date well completed November 16 19 56
Application for plugging filed November 16 19 56
Application for plugging approved November 16 19 56
Plugging commenced November 16 19 56
Plugging completed November 16 19 56
Reason for abandonment of well or producing formation Dry Hole

If a producing well is abandoned, date of last production _____ 19____
Was permission obtained from the Conservation Division or its agents before plugging was commenced? Yes

Name of Conservation Agent who supervised plugging of this well Eldon Petty
Producing formation _____ Depth to top _____ Bottom _____ Total Depth of Well 4100 Feet
Show depth and thickness of all water, oil and gas formations.

OIL, GAS OR WATER RECORDS

CASING RECORD

FORMATION	CONTENT	FROM	TO	SIZE	PUT IN	PULLED OUT
LANS-KC	Dry	3672	3896	8-5/8"	200'	None
ARBUCKLE	Dry	4062	4100			

Describe in detail the manner in which the well was plugged, indicating where the mud fluid was placed and the method or methods used in introducing it into the hole. If cement or other plugs were used, state the character of same and depth placed, from _____ feet to _____ feet for each plug set.

Hole filled with heavy mud.
Wood plug at 200' and dumped 20 sax cement and 1 sack hulls.
Wood plug at 40' and cemented to surface w/10 sax cement and 1 sack hulls.

STATE OF KANSAS
12/7/56
CONSERVATION DIVISION
Wichita, Kansas

(If additional description is necessary, use BACK of this sheet)
Name of Plugging Contractor Iron Drilling Company
Address 1206 Philtower Building, Tulsa, Oklahoma

STATE OF _____, COUNTY OF _____, ss.

(employee of owner) or (owner or operator) of the above-described well, being first duly sworn on oath, says: That I have knowledge of the facts, statements, and matters herein contained and the log of the above-described well as filed and that the same are true and correct. So help me God.

(Signature) Meritt H. Brown

SUBSCRIBED AND SWORN TO before me this 6 day of Dec., 1956

My commission expires 3-1-58
Ernestita Hopkins
Notary Public.

PLUGGING
FILE SEC 20 T. 9 R. 22W
BOOK PAGE 119 LINE 26

J.F. DARBY OIL Co.

DRILLING RECORD

Well: Farrell "B" No. 1
 SW SE SW, Sec. 20-9-22W
 Graham County, Kansas

200' 8-5/8" Surface Casing
 cemented w/150 sacks.

Work Commenced: 10-31-56
 Drilling Commenced: 10-31-56
 Drilling Completed: 11-15-56
 Work Completed: 11-16-56

WELL LOG

Clay & shale	0	to	30
Gravel & lime shells	30	to	60
Sand	60	to	125
Gravel, lime & shale	125	to	155
Blue shale	155	to	420
Shale & shells	420	to	990
Shale & sand streaks	990	to	1230
Shale	1230	to	1270
Shale, shells & sand	1270	to	1360
Shale	1360	to	1480
Sand & shale	1480	to	1625
Red bed	1625	to	1890
Red bed & shale	1890	to	1946
Anhydrite	1946	to	1987
Shale & shells	1987	to	2375
Shale	2375	to	2390
Shale & shells	2390	to	2500
Shale & lime	2500	to	2585
Lime & shale	2585	to	3324
Lime	3324	to	3359
Shale & lime	3359	to	3420
Lime	3420	to	4070
Arbuckle	4070	to	4100

4100 T.D.

RECEIVED
 STATE CORPORATION COMMISSION

DEC 5 - 1956

CONSERVATION DIVISION
 Wichita, Kansas

PLUGGING
 FILE SEC 20 T 9 R 22W
 BOOK PAGE 119 LINE 26