


STATE OF KANSAS
STATE CORPORATION COMMISSION

Give All Information Completely
Make Required Affidavit
Mail or Deliver Report to:
Conservation Division
State Corporation Commission
211 No. Broadway
Wichita, Kansas

WELL PLUGGING RECORD

Graham County, Sec. 20 Twp. 9 Rge. 22 (E) 22 (W)

Location as "NE/CNW4SW4" or footage from lines NW NE SW
Lease Owner J. F. Darby Oil Co.
Lease Name Farrell "B" Well No. 2
Office Address 1807 Philtower Bldg., Tulsa, Okla.
Character of Well (completed as Oil, Gas or Dry Hole) Dry Hole
Date well completed 6/10/58
Application for plugging filed " 19
Application for plugging approved " 19
Plugging commenced " 19
Plugging completed " 19
Reason for abandonment of well or producing formation Dry Hole

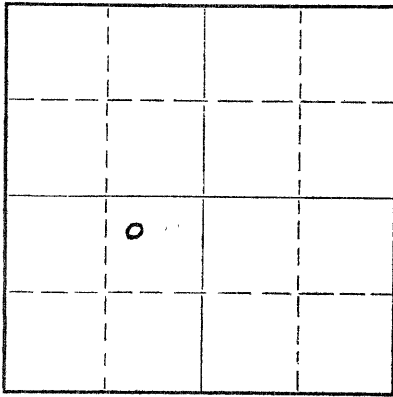

Locate well correctly on above Section Plat

If a producing well is abandoned, date of last production None 19
Was permission obtained from the Conservation Division or its agents before plugging was commenced? Yes

Name of Conservation Agent who supervised plugging of this well A. D. Fabricius
Producing formation _____ Depth to top _____ Bottom _____ Total Depth of Well 4110 Feet
Show depth and thickness of all water, oil and gas formations.

OIL, GAS OR WATER RECORDS

CASING RECORD

| FORMATION | CONTENT | FROM | TO | SIZE | PUT IN | PULLED OUT |
|--------------|---------|------|----|-------|--------|------------|
| Topeka | | 3100 | | 8-5/8 | 203 | None |
| Heebner | | 3624 | | | | |
| Lansing | | 3660 | | | | |
| Conglomerate | | 3993 | | | | |
| Arbuckle | | 4075 | | | | |

Describe in detail the manner in which the well was plugged, indicating where the mud fluid was placed and the method or methods used in introducing it into the hole. If cement or other plugs were used, state the character of same and depth placed, from _____ feet to _____ feet for each plug set.

Filled Hole with heavy mud to 600', Set cement plug using 25 sacks of cement.
Filled hole with heavy mud to 200', set wood plug & cemented with 15 sacks of cement.
Filled hole with heavy mud to 40', set Wood plug & cemented with 10 sacks of cement.

RECEIVED
6/25/58
JUN 25 1958
CONSERVATION DIVISION
Wichita, Kansas

(If additional description is necessary, use BACK of this sheet)

Name of Plugging Contractor Iron Drilling Company
Address 1206 Philtower Bldg., Tulsa, Okla.

STATE OF Oklahoma, COUNTY OF Tulsa, ss.
J. L. Stackpole (employee of owner) or (owner or operator) of the above-described well, being first duly sworn on oath, says: That I have knowledge of the facts, statements, and matters herein contained and the log of the above-described well as filed and that the same are true and correct. So help me God.

(Signature) J. L. Stackpole
1206 Philtower Bldg., Tulsa, Okla.
(Address)

SUBSCRIBED AND SWORN TO before me this 23 day of June, 19 58

My commission expires Feb. 28, 1960 Notary Public.

PLUGGING
FILE SEC 20 T 9 R 22 W
BOOK PAGE 109 LINE 7

DRILLING RECORD

J.F. DARBY Oil Co.
 Farrell "B" No. 2
 NW NE SW of Sec. 20-9-22W
 Graham County, Kansas

Casing Record

203' of 8-5/8" OD Surface
 Casing cemented w/ 160 sax.
 Dry Hole

Well Commenced 5/30/58
 Well Completed 6/10/58

Well Log

| | |
|--------------------------|-----------------|
| Clay | 0 to 100 |
| Sand | 100 to 180 |
| Shale | 180 to 203 |
| Blue Shale | 203 to 820 |
| Sand & Shale | 820 to 1425 |
| Band | 1425 to 1690 |
| Red Bed | 1690 to 1951 |
| Anhydrite | 1951 to 1988 |
| Shale | 1988 to 2030 |
| Shale & Lime | 2030 to 2650 |
| Shale | 2650 to 2740 |
| Shale & Lime | 2740 to 2815 |
| Shale | 2815 to 2875 |
| Shale & Lime | 2875 to 3265 |
| Lime | 3265 to 3270 |
| Lime & Shale | 3270 to 3405 |
| Lime | 3405 to 3868 |
| Lime & Shale | 3868 to 3894 |
| Conglomerate | 3894 to 3951 |
| Cherty Lime Conglomerate | 3951 to 3980 |
| Cherty Lime | 3980 to 3997 |
| Conglomerate | 3997 to 4105 |
| Arbuckle Lime | 4105 to 4110 TD |

C E R T I F I C A T I O N

State of Oklahoma)
) SS
 County of Tulsa)

I, Herrick Babcock, Partner of Iron Drilling Company,
 Certify that the accompanying is a true and correct log of the above
 described well.

Herrick Babcock

Subscribed to and Sworn before me this 23rd day of June, 1958

B. Michal

Notary Public

My Commission Expires:
 February 28, 1960

PLUGGIN
 FILE SEC 20 9 22W
 BOOK PAGE 109 7